


Township 47<sup>th</sup> N. Range 31<sup>st</sup> W. Mer. Mich.

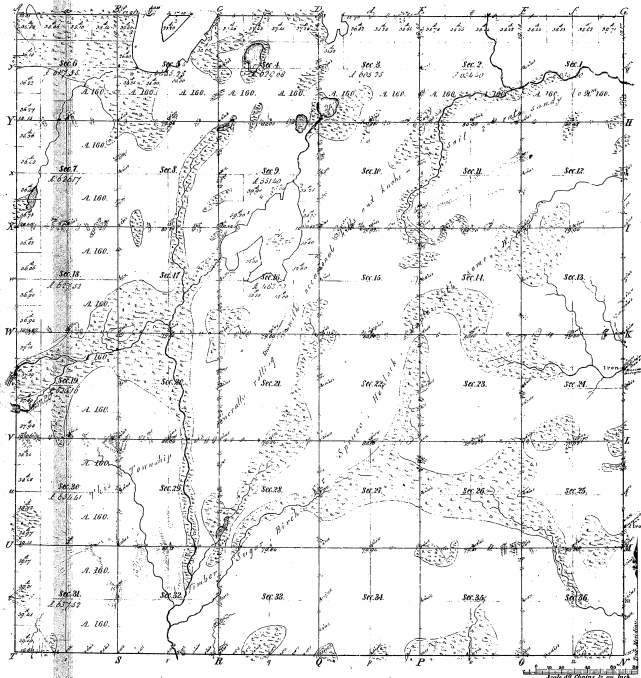

Masters of			
Pratt Course 1844	Pratt Course 1844	Pratt Course 1844	Pratt Course 1844
215 <sup>00</sup> 15			
45-15			
Total Acres 7 20 50			

Total number of Acres 7 20 50

Survey designated	By Whom surveyed	Date of Commencement	Amount of Survey	When Surveyed	How Surveyed
Township 47 <sup>th</sup> N. Range 31 <sup>st</sup> W.	J. B. Smith, et al.	1844	7 20 50	1844	By the 1st Sec. of the
Subdivisions	John B. Smith	1844	7 20 50	1844	By the 1st Sec. of the

The above copy of Township 47 North of Range 31 West of the Principal Meridian Michigan is truly and correctly the field notes of the survey thereof on file in the office and has been examined and approved by the Surveyor General's Office  
 Detroit, Mich. 1889  
 Lucius Lyon, Surveyor General

