


Township N. 11 North, Range N. 12 West Mer. (Mc.Tex.)

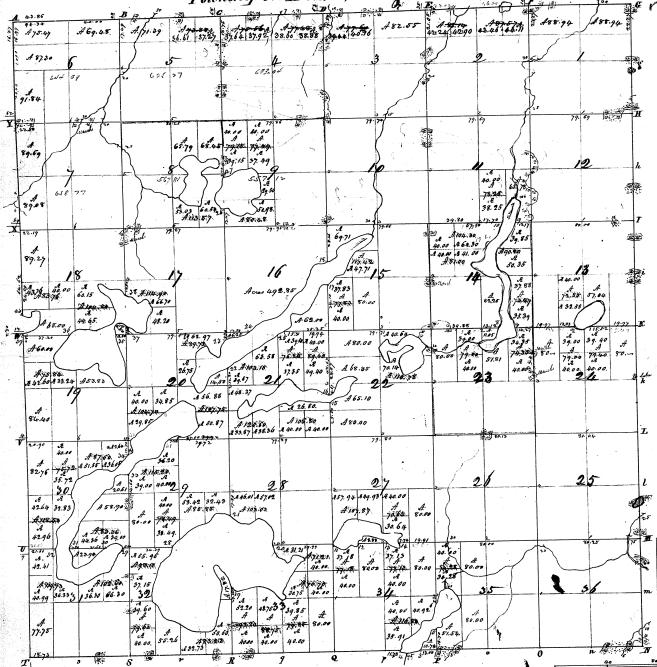

Surveyed in January, 1827 by Sebastian Sidney & Co.

Scale as set to standard

*[Handwritten signatures and notes, including the name 'C. H. ...']*

1	2	3	4	5	6	7	8	9	10	11	12	13	14	15	16	17	18	19	20	21	22	23	24	25	26	27	28	29	30	31	32	33	34	35	36		
...	...	...	...	...	...	...	...	...	...	...	...	...	...	...	...	...	...	...	...	...	...	...	...	...	...	...	...	...	...	...	...	...	...	...	...	...	...

36

Section	Acres	Owner	Section	Acres	Owner
1	36.00	...	17	36.00	...
2	36.00	...	18	36.00	...
3	36.00	...	19	36.00	...
4	36.00	...	20	36.00	...
5	36.00	...	21	36.00	...
6	36.00	...	22	36.00	...
7	36.00	...	23	36.00	...
8	36.00	...	24	36.00	...
9	36.00	...	25	36.00	...
10	36.00	...	26	36.00	...
11	36.00	...	27	36.00	...
12	36.00	...	28	36.00	...
13	36.00	...	29	36.00	...
14	36.00	...	30	36.00	...
15	36.00	...	31	36.00	...
16	36.00	...	32	36.00	...
17	36.00	...	33	36.00	...
18	36.00	...	34	36.00	...
19	36.00	...	35	36.00	...
20	36.00	...	36	36.00	...

7-36

Over line of Map