

Plot of Orangeville Island

in Gun Lake

in NW 1/4, Sec. 5, Tp. 2 N., R. 10 W., Mich. Meridian,

MICHIGAN.


*Surveyed by Walter Heath, U.S. Deputy Surveyor, Feb. 25-26, 1907,
under special instructions from the Com' of L. O., bearing date Dec. 11, 1906.*

Magnetic Variation, 1° E. East

Scale, 10 chs. to an inch.

7-35

7-35

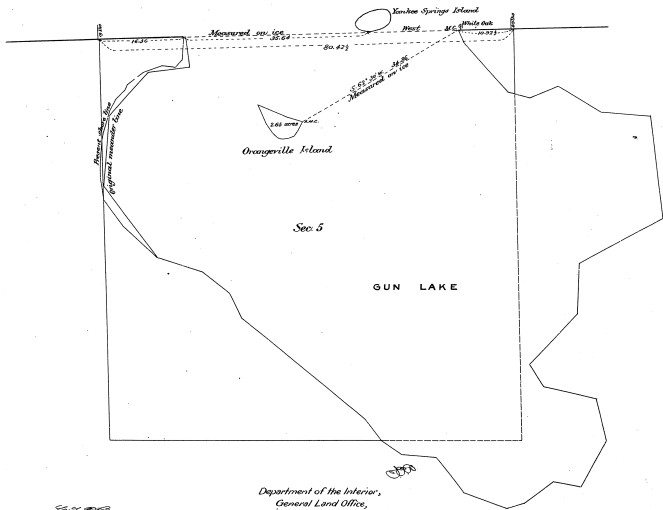

Department of the Interior,
General Land Office,


Washington, D.C., May 27, 1907.

The above plot of Orangeville Island in Gun Lake, in NW 1/4 Sec. 5, Tp. 2 N., R. 10 W., Michigan Meridian, Michigan, is a correct plot of a survey executed by Walter Heath, U.S. Deputy Surveyor, in pursuance of special instructions from the Commissioner of the General Land Office, bearing date Dec. 11, 1906, and is strictly conformable to the field notes of the survey thereof on file in this office, which have been examined and approved.

Re Bacon
Commissioner of the Office
U.S. Surveyor General for Michigan

7-35-8

TOWNSHIP 2 NORTH, RANGE 10 WEST, MICHIGAN MERIDIAN, MICHIGAN
 SURVEY OF BLACKBIRD ISLAND, SECTION 6

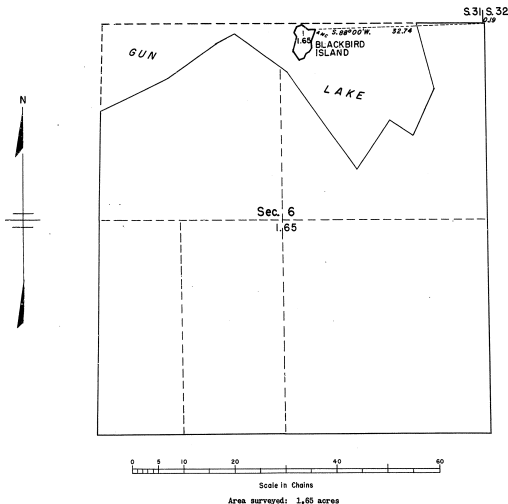

This plat represents the survey of Blackbird Island in Gun Lake which was not included in the original survey of the township which is represented on the plat approved April 24, 1927.

Surveyed by Hugh B. Crawford, Cadastral Engineer, from June 21 to 29, 1955, under Special Instructions for Group 65, Michigan dated April 26, 1905.

UNITED STATES DEPARTMENT OF THE INTERIOR
 BUREAU OF LAND MANAGEMENT
 Washington, D. C. March 23, 1956

This plat is strictly conformable to the approved field notes, and the survey, having been correctly executed in accordance with the requirements of law and the regulations of this Bureau, is hereby accepted.

For the Director

Acting Cadastral Engineering Staff Officer