


Township N. VIII South, Range N. XII West Abq. (Mts. Ter.)

L. S. L. E. M I C H I G A N.

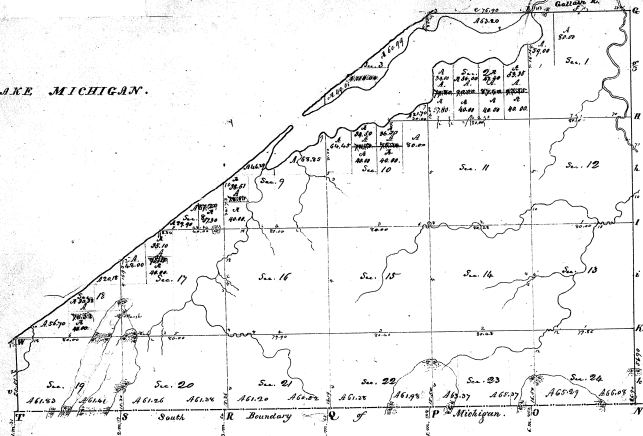

37

Sections		
Section	Area	Acres
1 NE	1	160
2 E. 1/2 SW	-	80
3 NW	-	160
4 SW	-	160
5 N. 1/2 SE	2	80
6 E. 1/2 SE	-	80
7 NW	-	160
8 E. 1/2 SW	-	80
9 NW	-	160
10 NW	-	160
Total		5760

1-37

Surveyed in October 1889 by James W. ...

Scale 1" = 400' or 1/4" = 100'