


Township (V. III south, Range (V. VIII west (misc. Co.)

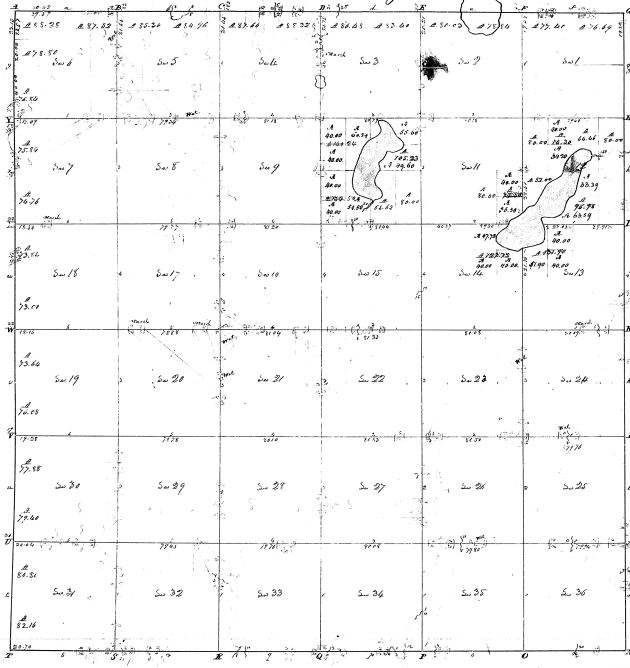

Surveyed in May 1854 by Robert Clark Sec. 2.

12.1.1	1	76	67	10	5	112	
12.1.1	2	80		10	10	131	80
12.1.1	3	77	10	10	10	120	
12.1.1	4	80		10	10	110	70
12.1.1	5	77	10	10	10	120	
12.1.1	6	78	80	10	10	120	
12.1.1	7	80		10	10	120	
12.1.1	8	80		10	10	120	
12.1.1	9	80		10	10	120	
12.1.1	10	80		10	10	120	
12.1.1	11	80		10	10	120	
12.1.1	12	80		10	10	120	
12.1.1	13	80		10	10	120	
12.1.1	14	80		10	10	120	
12.1.1	15	80		10	10	120	
12.1.1	16	80		10	10	120	
12.1.1	17	80		10	10	120	
12.1.1	18	80		10	10	120	
12.1.1	19	80		10	10	120	
12.1.1	20	80		10	10	120	
12.1.1	21	80		10	10	120	
12.1.1	22	80		10	10	120	
12.1.1	23	80		10	10	120	
12.1.1	24	80		10	10	120	
12.1.1	25	80		10	10	120	
12.1.1	26	80		10	10	120	
12.1.1	27	80		10	10	120	
12.1.1	28	80		10	10	120	
12.1.1	29	80		10	10	120	
12.1.1	30	80		10	10	120	
12.1.1	31	80		10	10	120	
12.1.1	32	80		10	10	120	
12.1.1	33	80		10	10	120	
12.1.1	34	80		10	10	120	
12.1.1	35	80		10	10	120	
12.1.1	36	80		10	10	120	
Total							74771

3-23

Surveyed in May 1854 by Robert Clark Sec. 2.