


Township. V^o 46 N. Range. V^o 1 E. Mer. Mich.

Mean Mer. 100° 15' 30" W. 1850

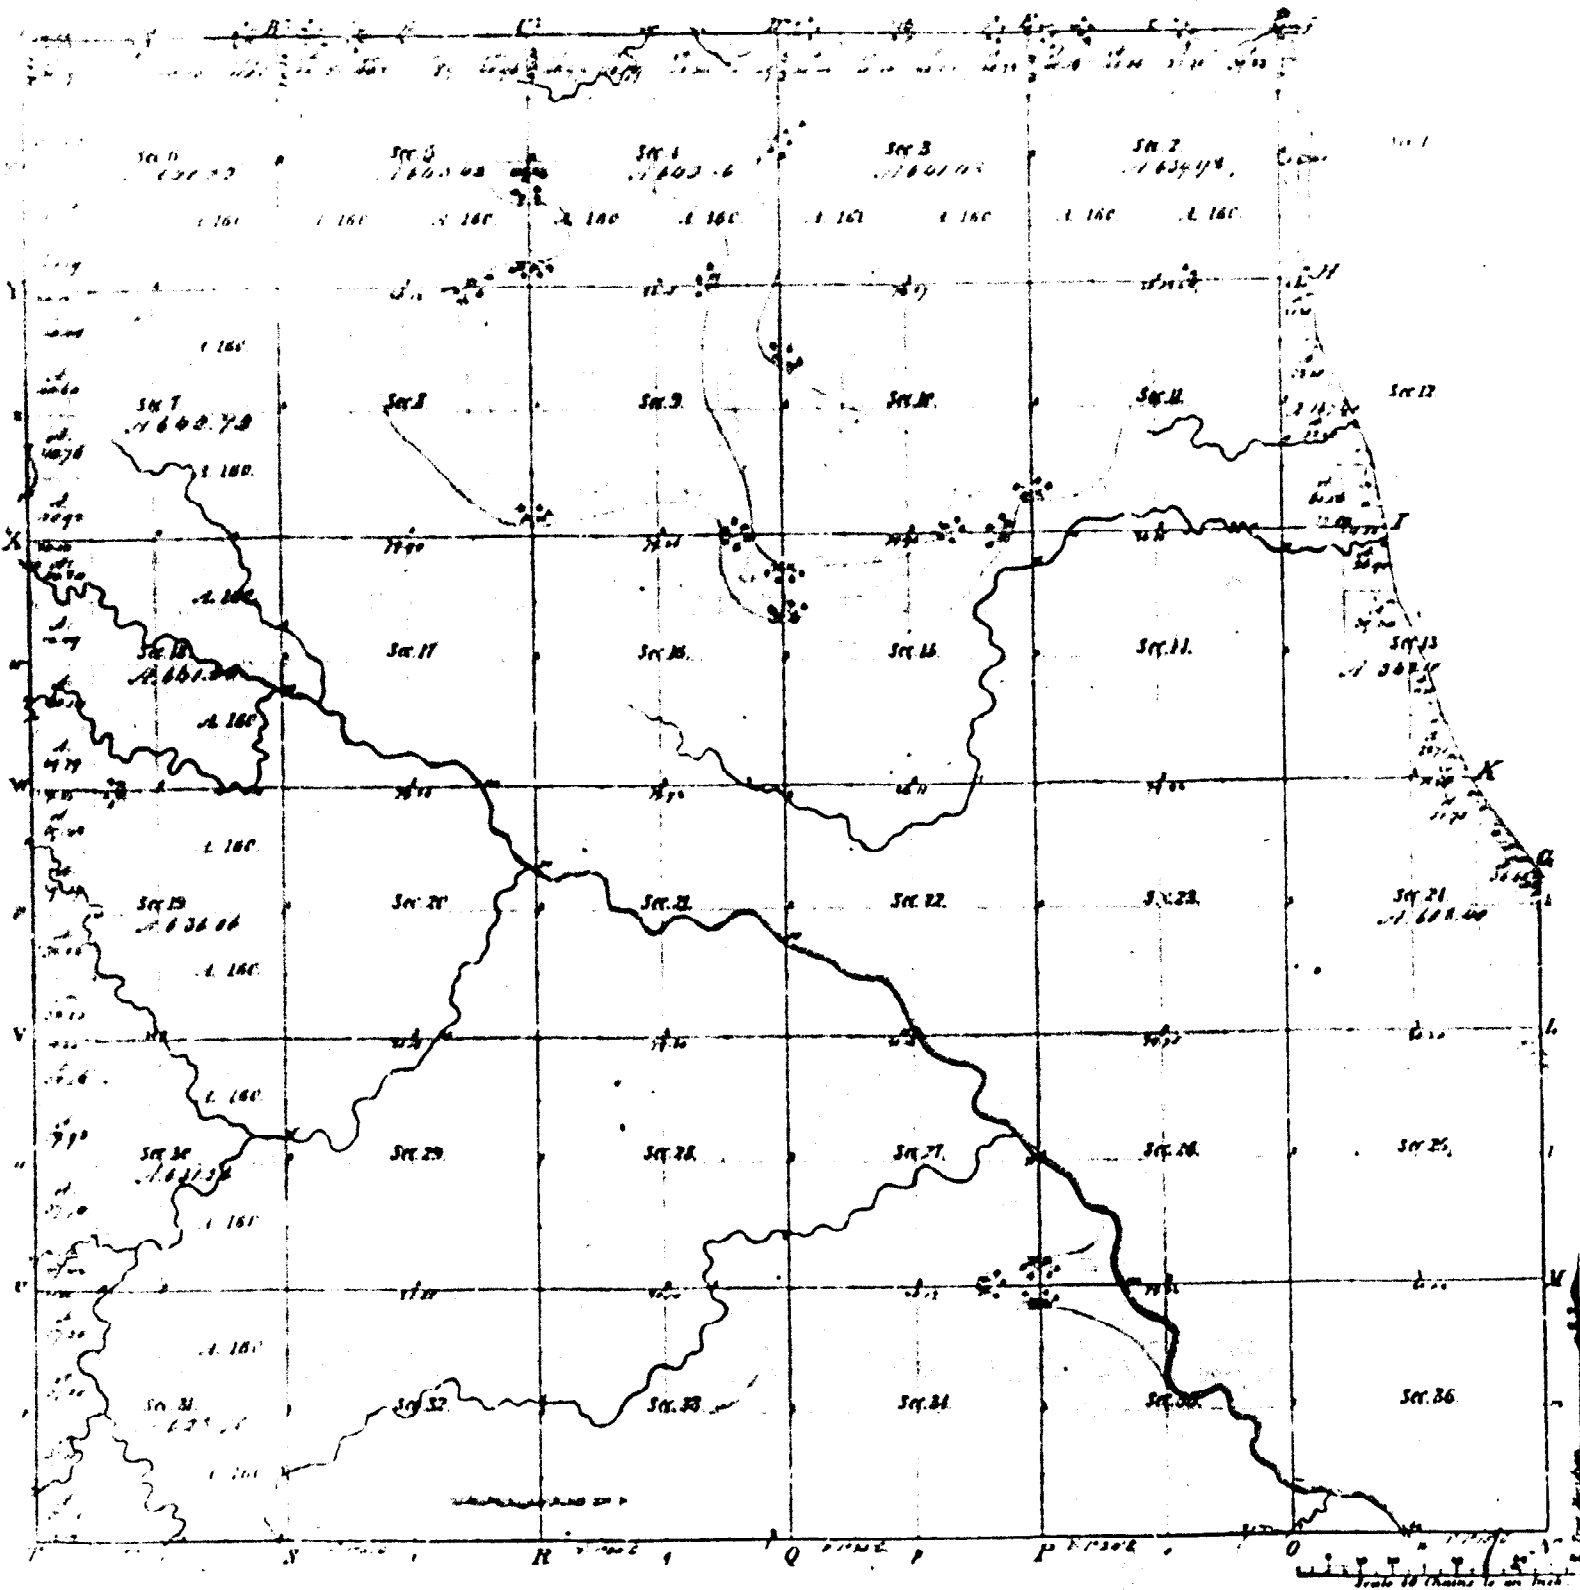

Total number of Acres. 2160.00

Original Plat	By whom Surveyed	Date of Contract	Amount of Survey	When Surveyed	When Plat'd
		Jan 16 1850	2160.00	1850	1850
		April 2 1850	6160.00	1850	1850

The above Map of Township V. 46 N. Range V. 1 E. Mer. Mich. is a true and correct copy of the original map of the survey thereof on file in this Office, which have been examined and approved by the Surveyor General's Office Detroit Mich. 21. 1850