




DIAGRAM  
 of the survey of an Island  
 IN SEC. 3, TOWNSHIP 39 N., RANGE 30 W.  
 MICHIGAN MERIDIAN.  
 H.C. Zeller, Surveyor.

Scale : 4 Chains = 1 inch .

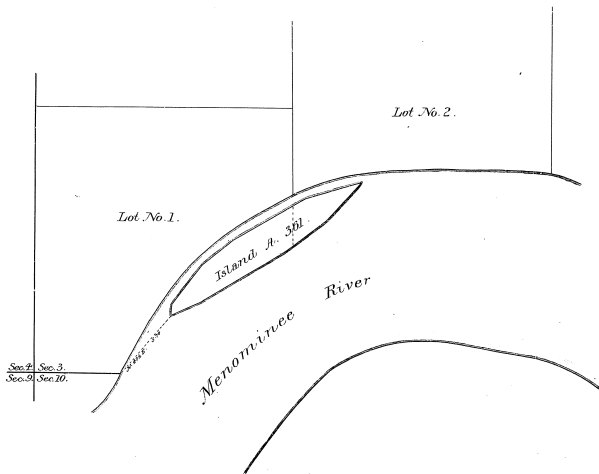

SENT  
DAB

Department of the Interior  
 General Land Office

Washington, D.C., Dec. 15<sup>th</sup> 1892.  
 The above Diagram of the survey of an Island situated in  
 Menominee River in Sec. 3, Township 39 N., Range 30 W. Michigan Mer.  
 Michigan, is strictly conformable to the field notes of the survey thereof  
 on file in this Office, which have been examined and approved.

*W. Johnson*  
 Comm'r. General Land Office  
 and Ex-officio Sur-Gen'l for Michigan.