


Township 1° 38' N Range 1° 5' W Mer.

L. MICHIGAN

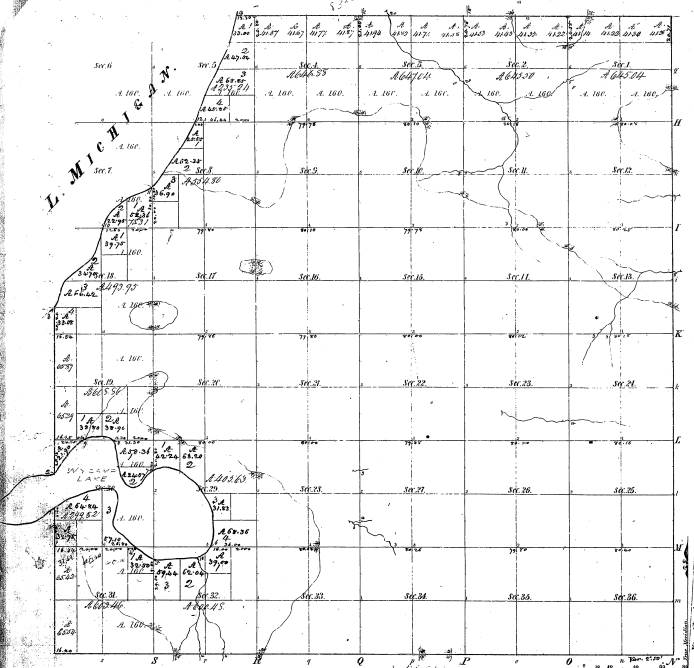

Boundaries of Sections

Foot Contour (1/4 in. = 100 ft) Contour

1	1000
2	1000
19-70

Total number of Acres 20,521.71

Survey Designated	When Surveyed	Date of Contract	Amount of Survey	When Surveyed	When Surveyed
Township lines	1870	1870	1870	1870	1870
Sections	1870	1870	1870	1870	1870

The above Map of Township 1° 38' N. of Range 1° 5' W. of the Principal Meridian, Michigan, is a study conformable to the field notes of the survey thereon on file in this Office, which have been examined and approved.

Surveyor General's Office
Grand Rapids, Feb. 2, 1881.

C. S. Peckham