


Township N^o VIII East, Range N^o VII East of m. (M. 11 11)

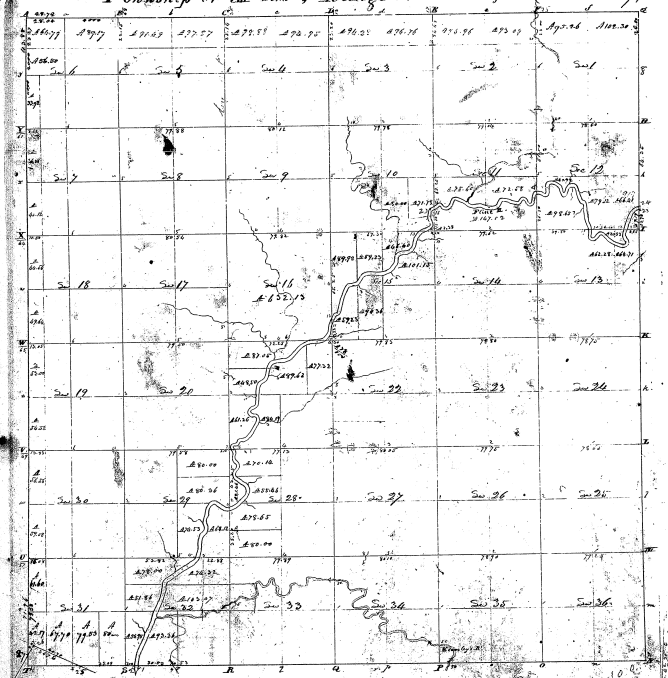

27 616 61

Consent to a contract with and instructions from Edward T. Fox, Surveyor General of the United States, bearing out the
 claim of
 I have nevertheless had out and surveyed the above described as is certified that it is such
 and have had the same laid out and surveyed as is represented on said plat and recorded in the field notes and books
 of the Surveyor General of the United States, which books are open to the inspection of all persons.
 Surveyed and recorded

28-11
 28-11