


Township 1st 44^N Range 1st 38^W Mer. Mich.

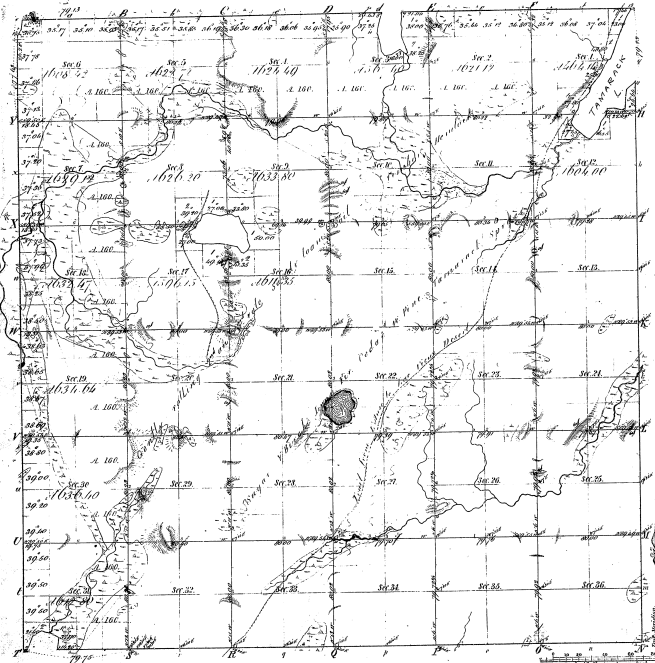

Boundaries of
Poth Contests 1842nd Poth Contests 1842nd Poth Contests 1842nd

42-52

43-32

Wentworth's South 80 chains N. of r.k.

Total number of Acres 22525.20

Survey Designated	By Whom Surveyed	Date of Contact	Amount of Survey	When Surveyed	When Filed and of What Date
Township lines	Wentworth's South April 22 1847		21.25 44	2 nd Class 1847	
Subdivisions	Locke & Street April 23 1846		64.25 52	3 rd Class 1846	

The above Map of Township 1st 44^N Range 1st 38^W of the Principal Meridian Michigan is truly and lawfully the full and correct survey thereof as filed in the office which have been examined and approved.

Surveyor General's Office
Detroit July 16 1857

Charles Little Surveyor

Surveyor