


Township N^o 48 N. Range N^o 44 W. Mer. Mich.

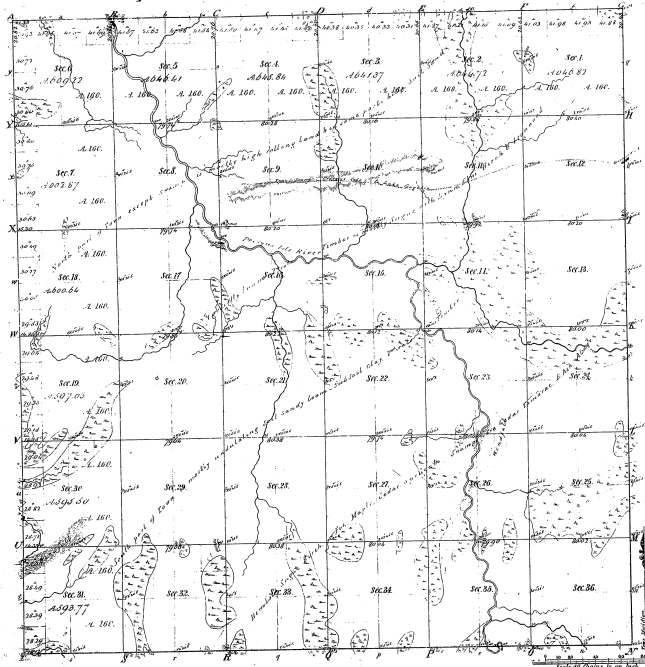

Reminders of
 1stst course 1024th feet course 1012th feet course 1024th

42 20

42-20

Total number of Acres 22824.79

Survey Designated	By Whom Surveyed	Date of Commencement	Amount of Survey	When Surveyed	Where of use at the time
Township lines	W.A. Austin	April 22 nd 1847	36 Secs.	1847	for Com. use
Subdivisions	Austin & Bates	March 18 th 1848	36 Secs.	1848	for Com. use

The above copy of Township N^o 48 North of Range N^o 44 West of the Principal Meridian Michigan was so fully conformable to the field notes of the survey thereof on file in this Office which have been examined and approved.

Surveyor General's Office
 Detroit August 2nd 1848
 Successor, Geo. S. ...