


Township N<sup>o</sup> 19 N. Range N<sup>o</sup> 75 W. Mer. Mich.

Section 1  
 Post Office (N<sup>o</sup> 19) Post Office (N<sup>o</sup> 19) Post Office (N<sup>o</sup> 19)

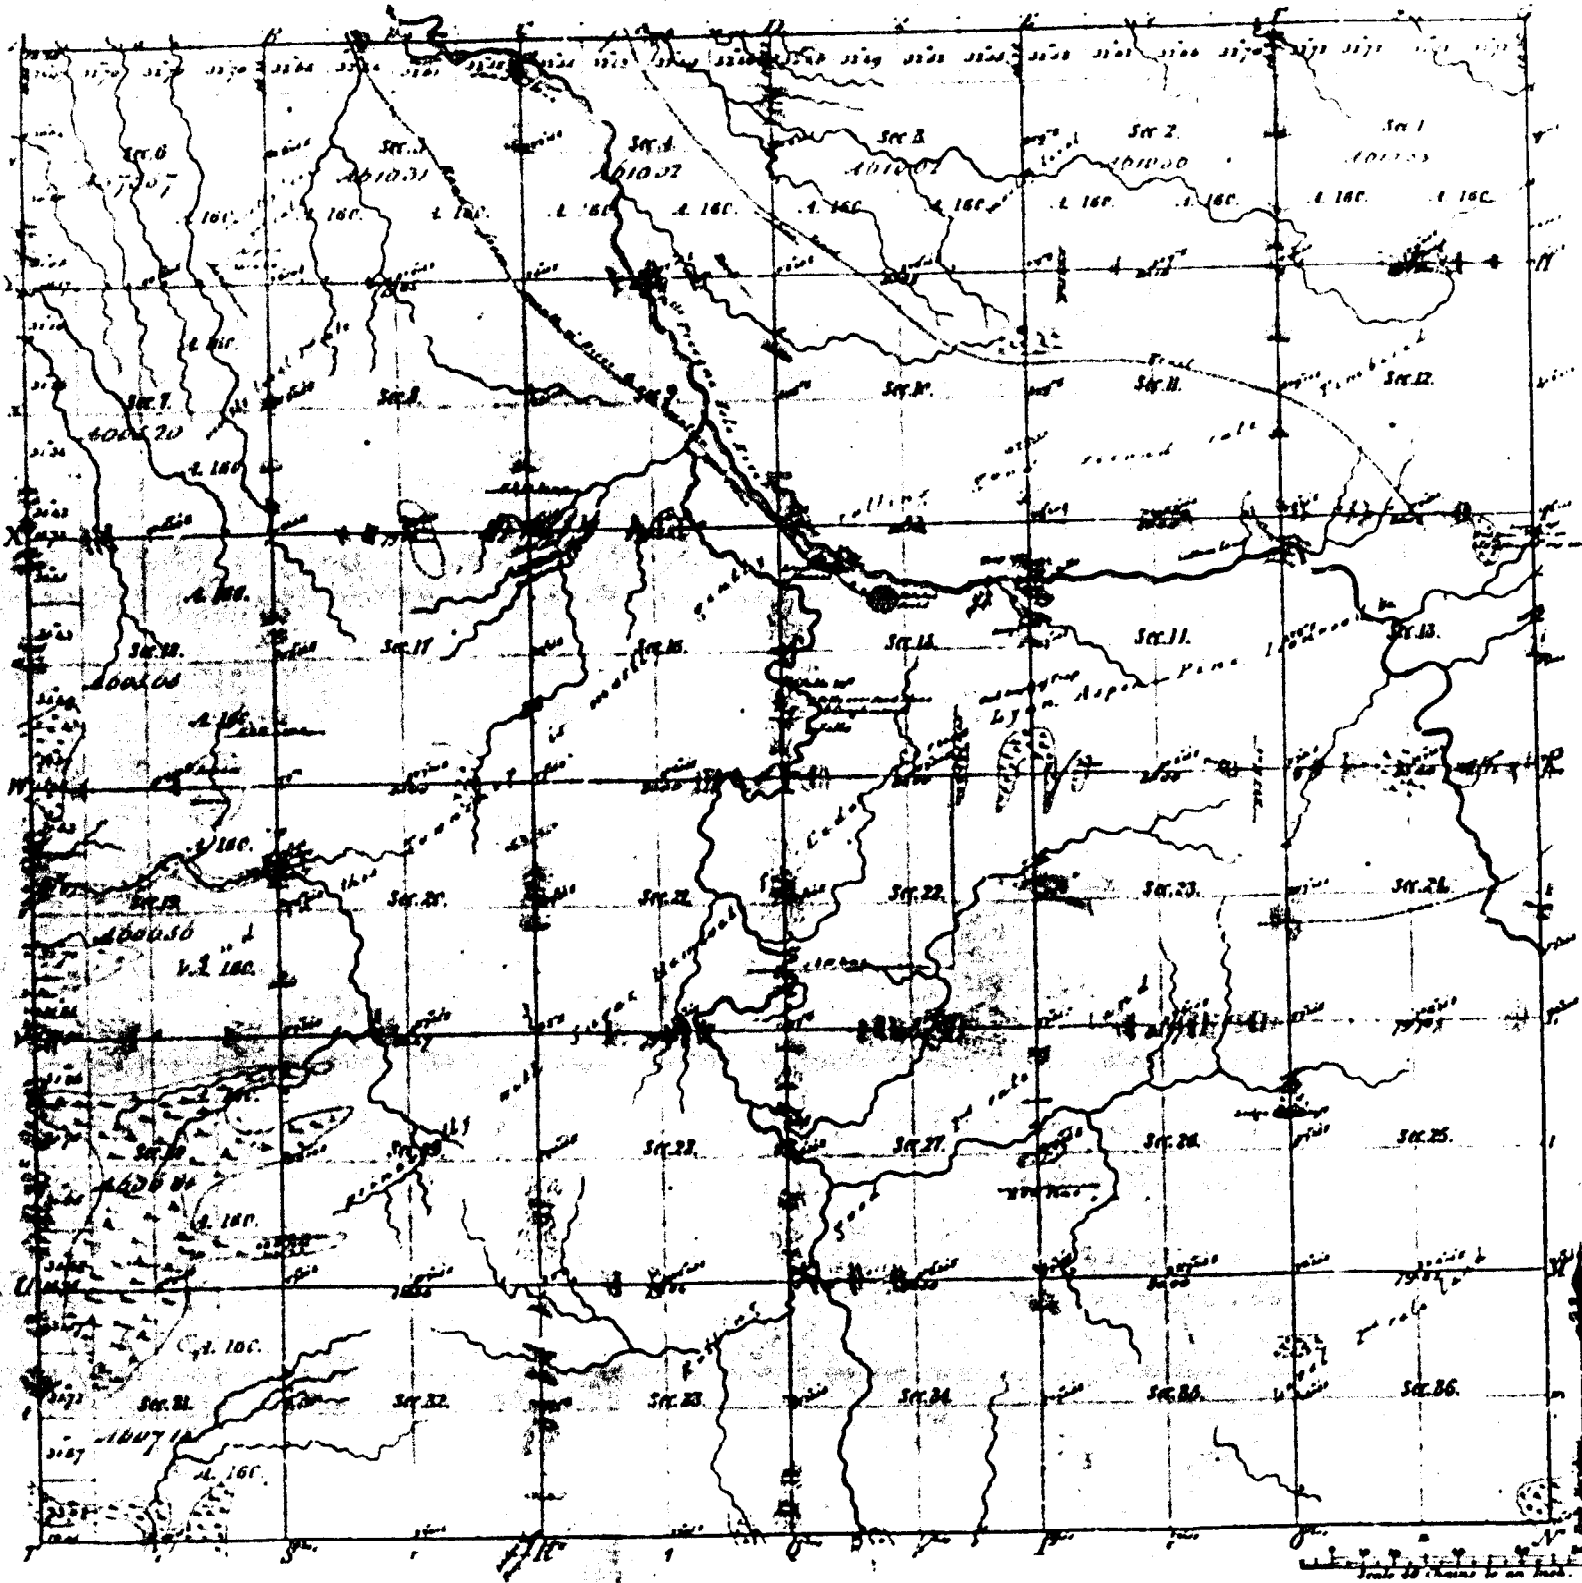

42-11

Total number of Acres 27658 70

Tracts Designated	By Whom Surveyed	Date of Contract	Amount of Survey	When Surveyed	When of the land is in the Sec. Com <sup>o</sup> and?
Township lines	A. S. S. S. S. S. S. S.	April 27 1847	M. 62 1/2	Sec. 1-36	1847
Subdivisions	William Hall	Dec 10 1847	S. 11 1/2	Sec. 1-36	1847

The above Map of Township N<sup>o</sup> 19 N. Range N<sup>o</sup> 75 West Mer. Mich. is strictly conformable to the field notes of the survey thereof on file in this Office, which have been examined and approved.  
 Surveyor General's Office.  
 Detroit Jan<sup>y</sup> 27. 1847  
 Lucius Lyon, Surveyor