


Re-survey

Township, 1^o 25 N Range, 1^o 9 W Mer. Mech.

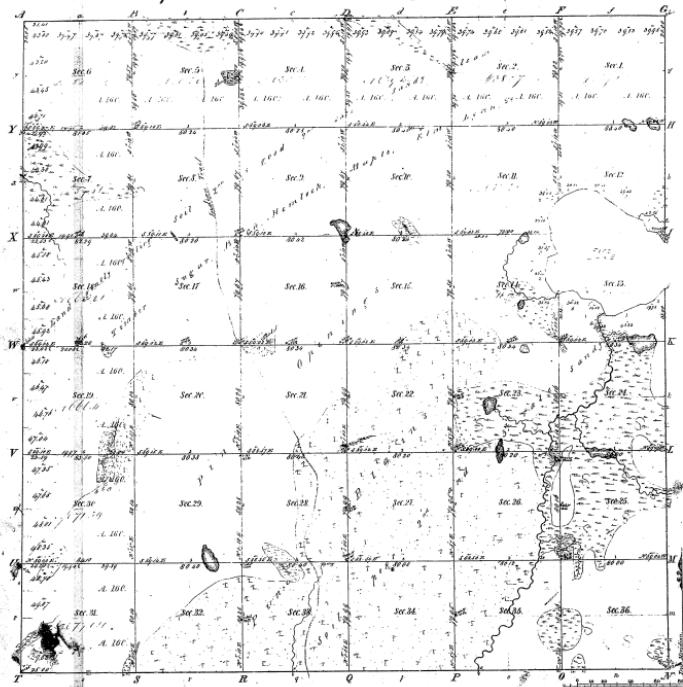

Total number of Acres - 22,539.00

<u>Surveyor's Designation</u>	<u>By whom Surveyed</u>	<u>Date of Original Survey</u>	<u>Amount of Survey</u>	<u>When Surveyed</u>	<u>Where Surveyed</u>
E. B. Wright Times Subdivision	John Brink	Sept. 14 th 1858.	46 - 00 - 00	5 th Oct. 1858.	5 th Oct. 1858.
	W. H. C. R. A.	Sept. 14 th 1858.	46 - 00 - 00	5 th Oct. 1858.	5 th Oct. 1858.
E. B.	Aaron Burt	Aug. 25 th 1858.	6 - 00 - 00	2 nd Oct. 1858.	2 nd Oct. 1858.

The above Map of Township 12 & Range 10 of Rema 10, is the field
Principal Meridian of Michigan is nearly conformable to the field notes
of the survey thereof for file in this Office, which have been examined and approved.

General's Office. *Seal of the Commonwealth*
Massachusetts. *Seal of the Commonwealth*

PLAT of two Islands

in File Lake, in Secs 13 and 14, Tp. 25 N., R. 9 W., Michigan Mer.

MICHIGAN


*Surveyed by Delmar E. Teed, U.S. Dep. Surveyor, April 15-16, 1903,
under special instructions from the Com' G.L.B. dated Dec. 17, 1902.*

Scale 10 cm = 1 inch.

16-21

2

16-2

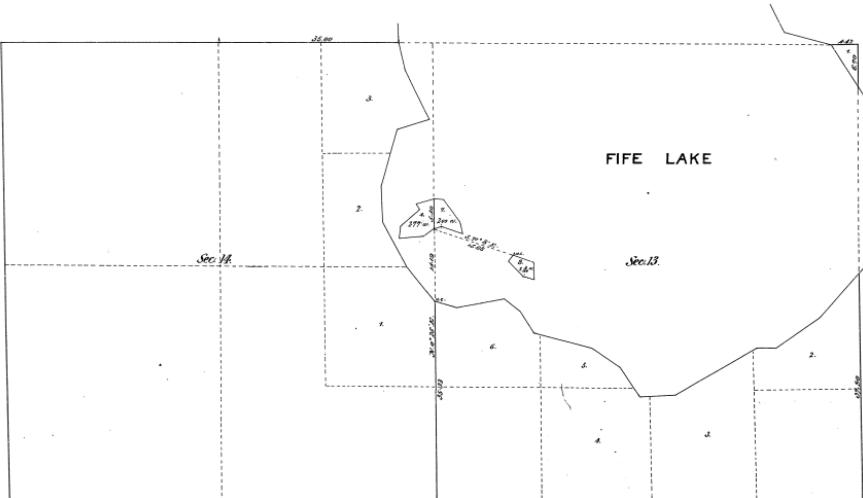

Department of the Interior

DEPARTMENT OF THE INTERIOR

Washington DC Oct. 5th 1922

The above plot of two Islands, in Fife Lake, in Sec's 13 and 14, To 25 N., R.9 W., Michigan Meridian, Michigan, is a correct plot of a survey executed by Delmar E. Tread, U.S. Deputy Surveyor, in pursuance of special instructions from the Commissioner of the General Land Office, bearing date 1st. 17. 1902, and is strictly conformable to the field notes thereof on file in this office, which have been examined and approved.

W. A. Reckord.

Commissioner and ex-officio
Surveyor General for Michigan