


Township N: 11 south, Range N: 1 west Mer. (Mich. Ter.)

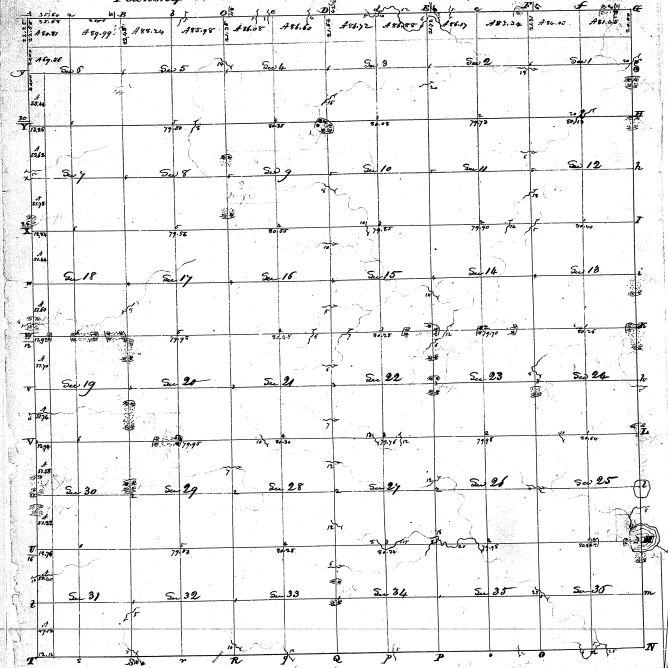

22,798.81

Pursuant to a contract with (and instructions from Edward Duffie, Surveyor General of the Western State, bearing date the day
 I have commenced laid out and surveyed the above land for (and in behalf of) the State of Michigan, and have such books
 and bounds both returned and satisfied as are requisite on said plot (and described in the field notes made thereof) and
 returned with the field into the Surveyor General's office. Witness this 20th day of May 1820--

Robert C. Cook

4-10

H-10