


Township N. VII south, Range N. E. West Mer. (1856)

26

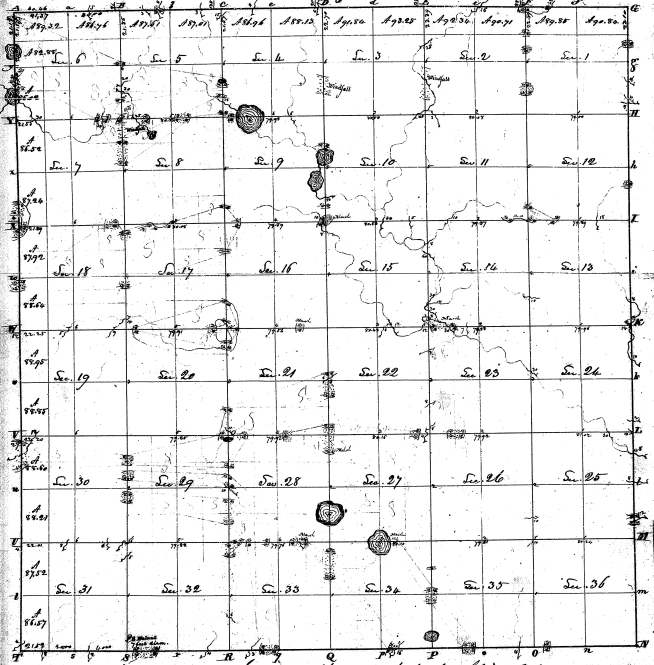

4-26

4-26

Surveyed in April, 1856, by W. Bradford Esq.

22 222.17