


Township N. VIII South, Range N. I West Mer. (Mich. Ter.)

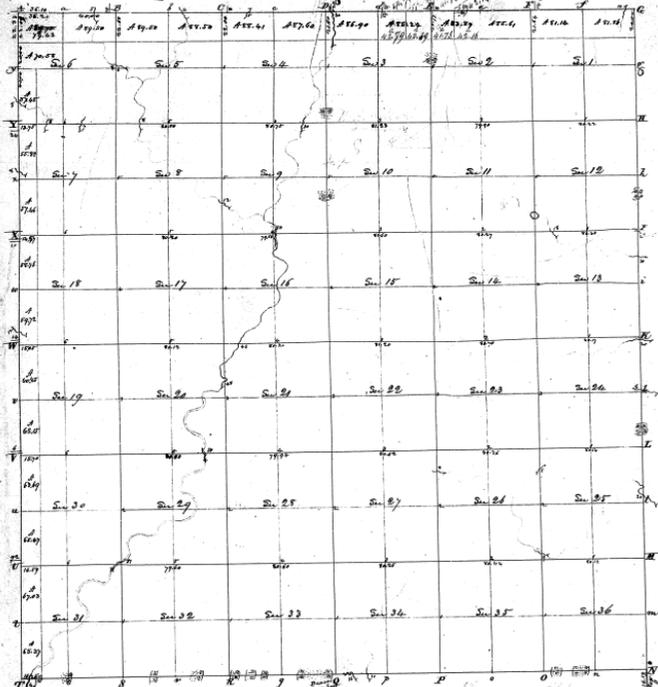

4-28

4-28

37.40
 Pursuant to a contract with said institution from Edward J. Sawyer General of the United States, bearing date the
 same concerned said land being the above township and is hereby that it had not been
 and bounds both natural and artificial as are ascertained on said plan and numbered in the first notes were thereby set
 returned with the list into the Sawyer General's office. Witness the 5th day of May 1824
 T. L. Swan, L. O.