


Township N. VII south, Range N. II west Mer. (E. Ter.)

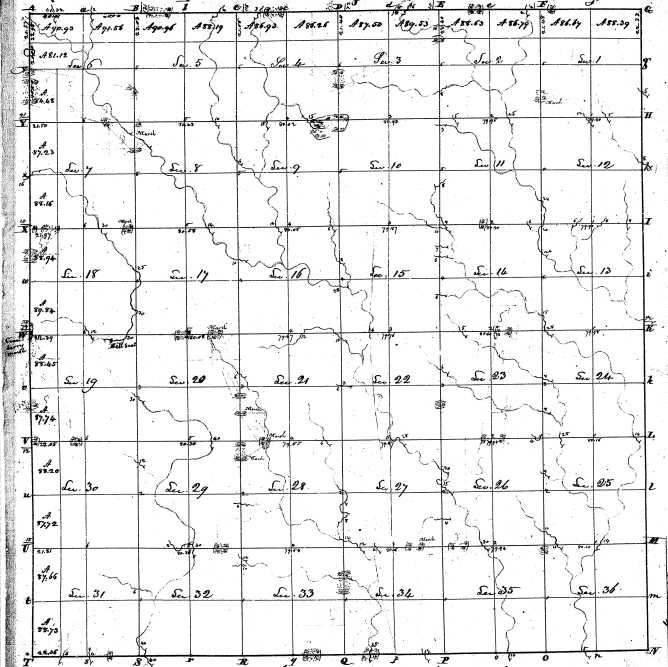

Surveyed in March 1895 by W. B. Phillips, Sr.

28,200 61

4-29

4-29