


Township *N. 17* and *N. 18* Range *N. 11* East, (Columbia Twp.)

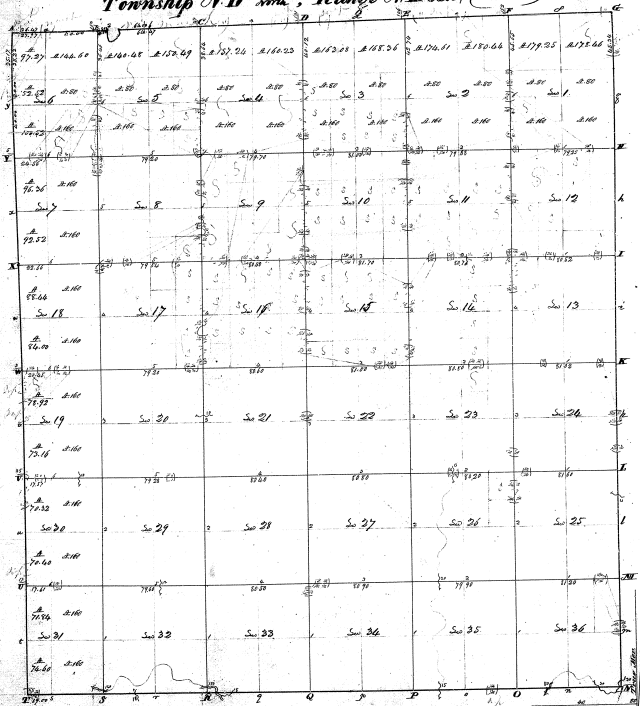

Surveyed in April 1826 by Joseph Wampler D.S.

Scale according to this Plan

29-26

29-26

Table of Contents				
Sec. Cont.	Acres	Sec. Cont.	Acres	Acres
Pt. 1	128	41	Sum 20	640
Sx	10		21	640
Pt. 2	179	25	22	640
Sx	320		23	640
Pt. 3	180	41	24	640
Sx	50		25	640
Pt. 4	174	68	26	640
Sx	50		27	640
Sx	520		28	640
Pt. 5	128	56	Ex. 29	320
Sx	50		S. 30	72
Pt. 6	163	18	S. 31	50
Sx	50		Ex. 32	520
Sx	320		33	72
Pt. 7	160	23	S. 34	24
Sx	50		Ex. 35	640
Pt. 8	157	20	S. 36	640
Sx	50		Ex. 36	640
Pt. 9	320		S. 37	640
Pt. 10	150	49	Ex. 38	640
Sx	50		Sum 8	640
Sx	320		9	640
Pt. 11	146	61	10	640
Sx	50		11	640
Pt. 12	77	27	12	640
Sx	100		13	640
Sx	100		14	640
Ex. 13	320		15	640
Sx	72		16	640
Sx	98		17	640
Sum 8	640		18	640
9	600		19	640
10	620		20	640
11	640		21	640
12	640		22	640
13	640		23	640
14	640		24	640
15	640		25	640
16	640		26	640
17	640		27	640
18	640		28	640
19	320		29	640
20	75	22	30	640
Sx	75	16	31	640
			32	640
			33	640
			34	640
			35	640
			36	640
			Sum 8	88
			Ex. 19	320
			20	75
			S. 31	75
			Sum 8	98
				13560

Seal

Geo. S.

1824
1824