


Township 1^o N. Range 36 W. Mer. Mich.

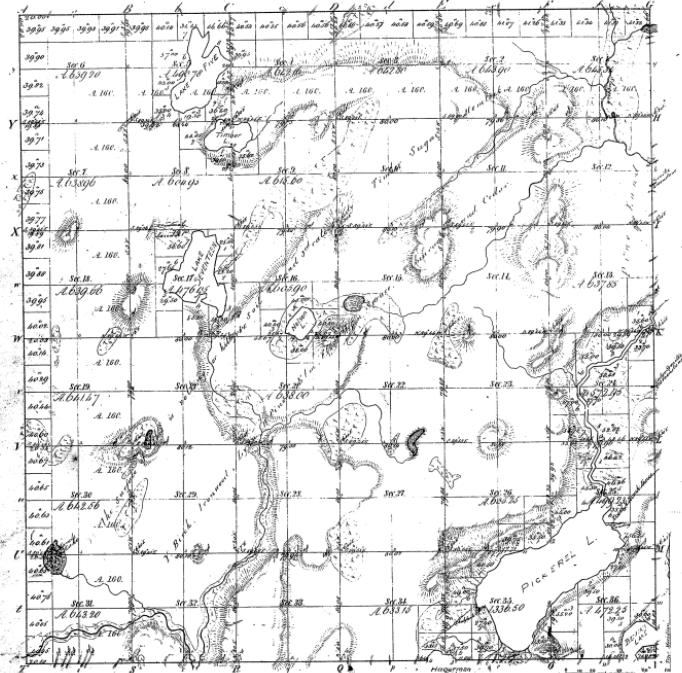

Total number of Acres 21,058 11						
Survey Designated	By whom Surveyed	Date of Contracts	Number of Surveyors	When Surveyed	What is done and what is left to be done in the said Survey	What is done and what is left to be done in the said Survey
Township Survey	W. H. & C. B. Burt	Sept. 1867-1868	2	Oct. 1868	Completed	Completed
Highway Survey	W. H. & C. B. Burt	Sept. 1867-1868	2	Sept. 1868	Completed	Completed

The above Map of Township 1^o N. Range 36 W. of the
State of Michigan is made conformable to the field notes
of the Survey thereof on file in this Office, which have been examined and approved.

Surveyor General's Office
Detroit, Mar. 1872
Charles H. Bell, Surveyor.

43-35