


Township XIV. Range N^o III w. Mer. Michigan Territory.

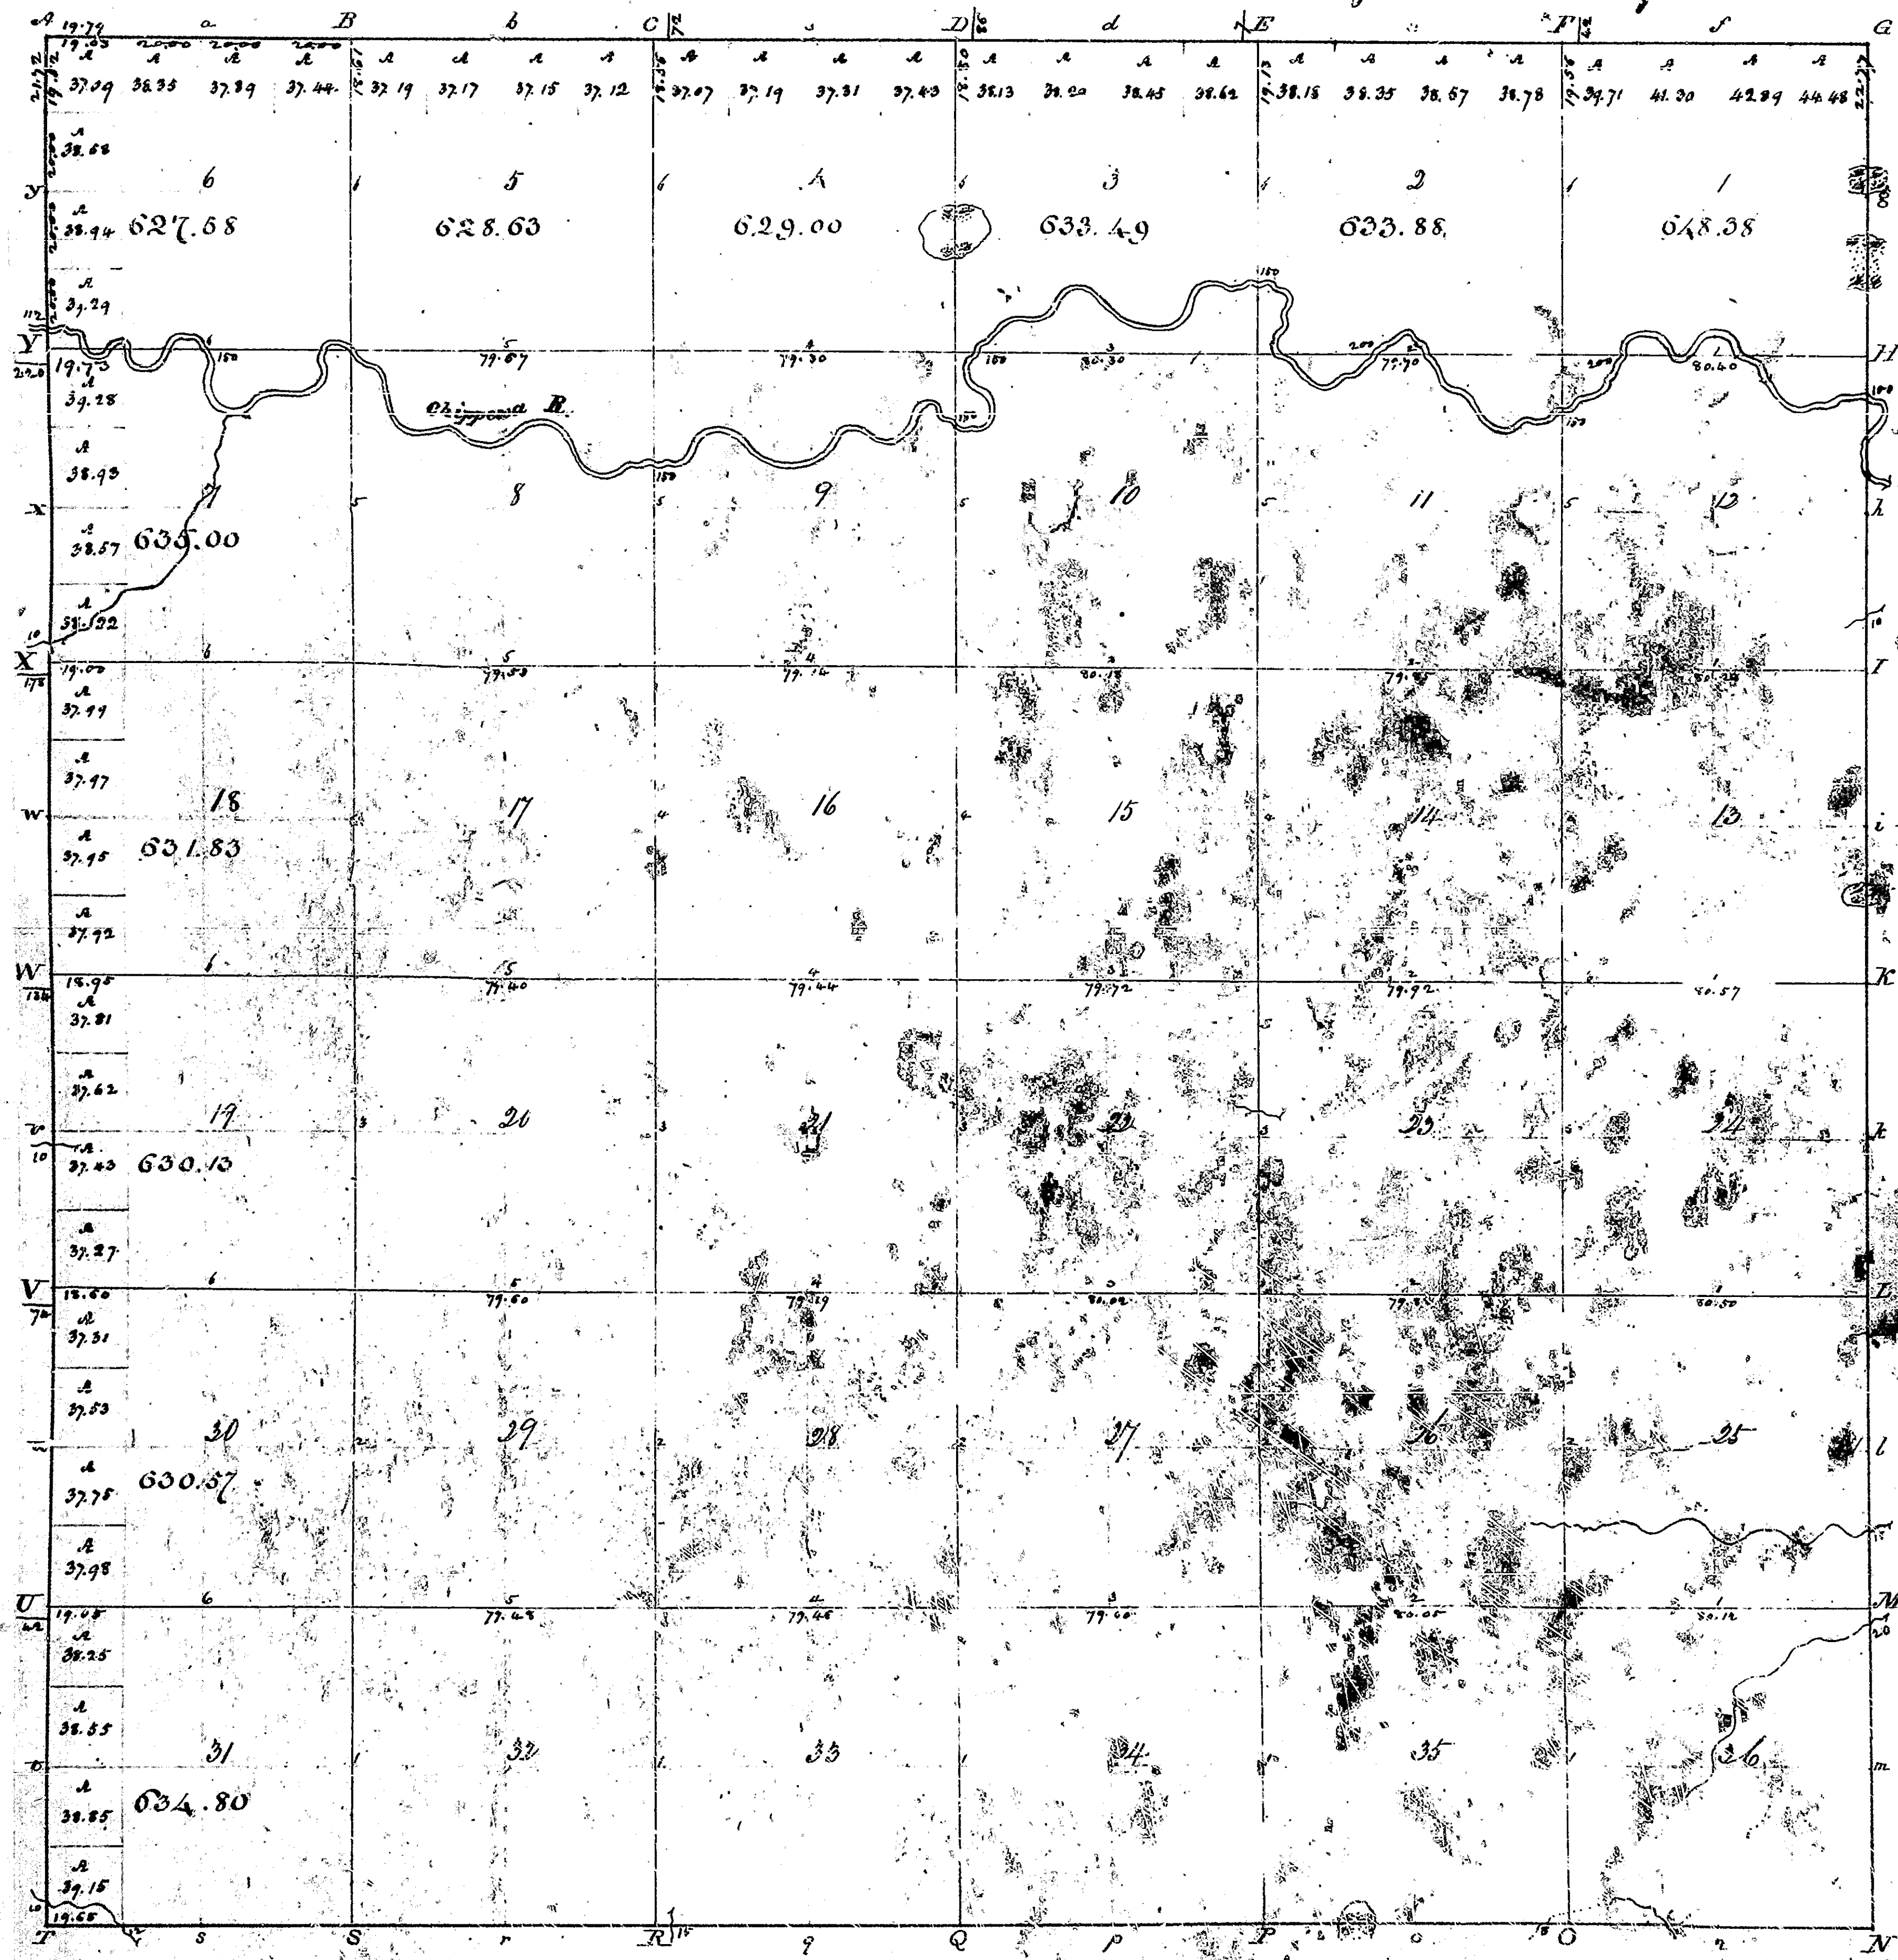

Total Number of Acres 22,962.9

Scale 40 Rods to an Inch

Survey designated	By whom surveyed	Date of Contract	Acres of Survey	When Surveyed	By whom
Town boundaries	R. Clark	17 Nov. 1830			
Subdivisions	Jacob Wright	1 Dec. 1830	59 69.99	3 ^d of 1832	J. J. 1832

The above Map of Township No. 14 North of Range N^o III West of Meridian Michigan Territory is a true and correct copy of the original Survey Book on file in the office of the Surveyor General and approved by the Surveyor General's Office on the 21st of Sept. 1832.

Wm. T. Williams
Surveyor Genl.

13-27

13-27