


(McMahon)

13-21

Township No. 15 N., Range No. 4 West Mer. (Mich.)

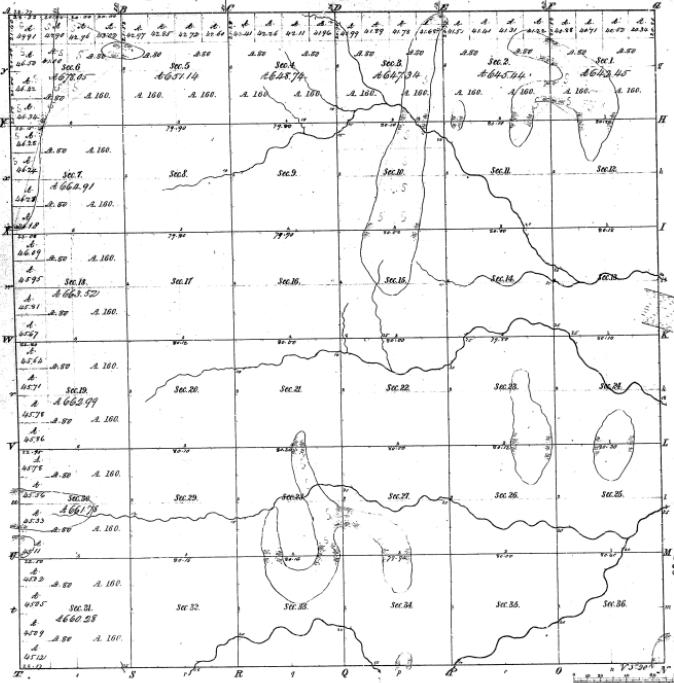

Section Number	Plots Contained in Section				Total Area
	Block	Plot	Section	Total	
1					
2					
Total number of Acre's 23,226.69

Survey Designated	By whom Surveyed	Date of Survey	Amount of Surveyed	When Surveyed	On the
Township lines	John Edgerton	Aug 18 th 1827	24.000	1827	1827
Subdivisions	John Edgerton	Aug 19 th 1827	16.19 .59	Aug 1827	1827

The above Map of Township 15 N., Range 4 West of the
Principal Meridian, Michigan, is strictly conformable to the field notes
of the survey there on file in this office, which have been examined and approved.


Surveyor General
Cincinnati, June 1, 1829
R. Geering, Surveyor!

ORIGINAL

TOWNSHIP 15 NORTH, RANGE 4 WEST, OF THE MICHIGAN MERIDIAN, MICHIGAN.

DEPENDENT RESURVEY

J-22

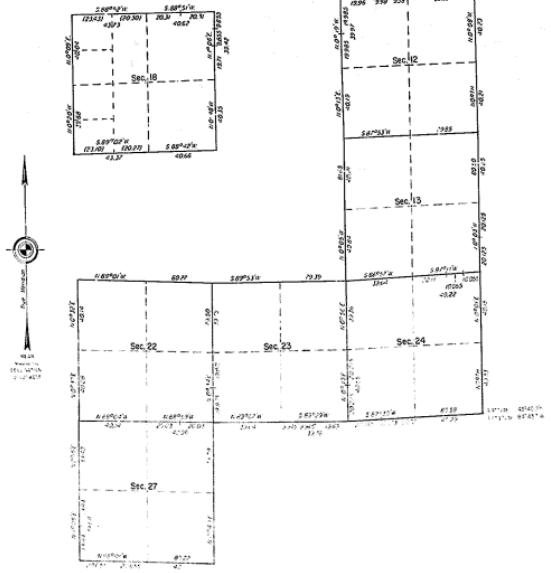

A history of surveys is contained in the field note record.

This plan represents the dependent resurvey of a portion of the east and west boundaries, and a portion of the subdivisional lines, designed to restore the original corner points and lines, as far as possible, from the best available evidence, T. 15 N., R. 4 W., Michigan Meridian, Michigan.

The lots and areas are as shown on the plat approved June 7, 1835.
Survey executed by Stewart J. Avery, Geodetic Surveyor, beginning May 21, 1882, and completed June 9, 1882, pursuant to Special Instructions for Group No. 85, Michigan, dated September 18, 1881.

UNITED STATES DEPARTMENT OF THE INTERIOR
BUREAU OF LAND MANAGEMENT
Alexandria, Virginia October 5, 1983

This plan is strictly conformable to the approved field notes, and the survey, having been correctly executed in accordance with the requirements of law and the regulations of this Bureau, is hereby approved.

For the Director

[Signature]
Chief Geodetic Surveyor
United States M.L.S.

TOWNSHIP 15 NORTH, RANGE 4 WEST, OF THE MICHIGAN MERIDIAN, MICHIGAN.
CORRECTIVE DEPENDENT RESURVEY

