


Township 12<sup>th</sup> south, Range 12<sup>th</sup> west (Wind Run)

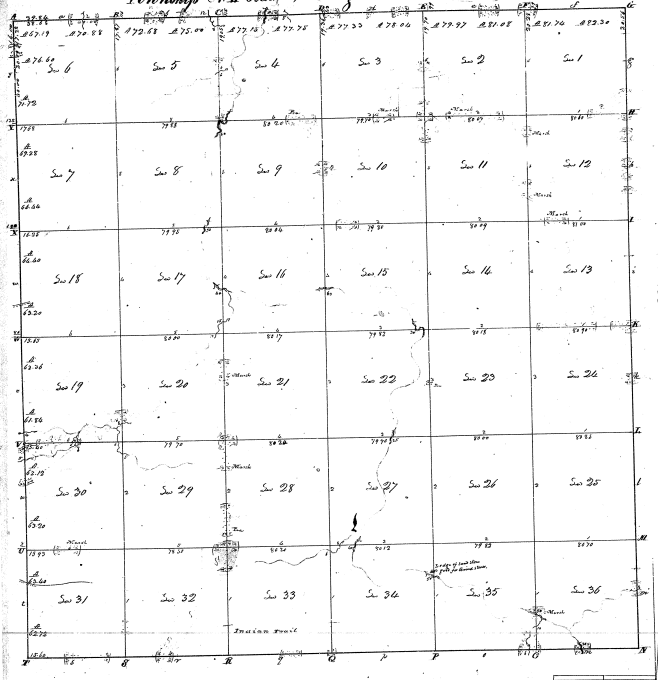

3-12

3-12