


15-220

Resurvey
Township 1st 26^N Range 1st 5^W Mer. Mich.

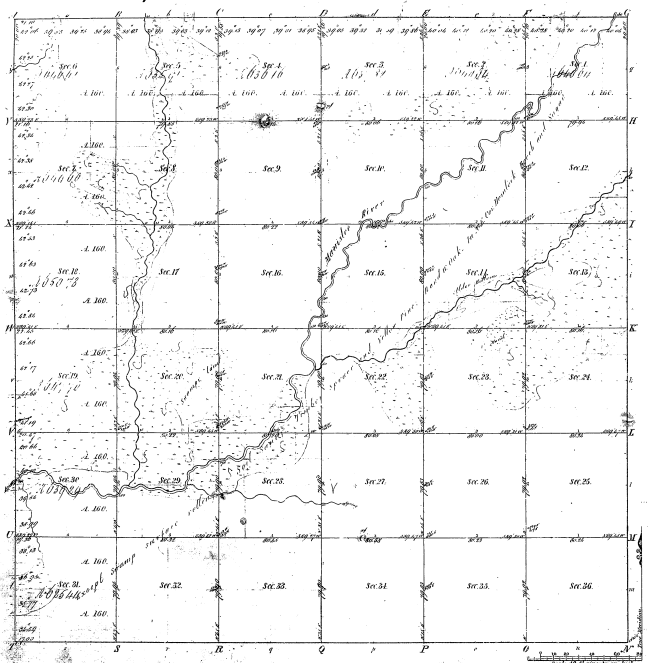

Number of Acre Acres	Acres	Acres	Acres
	15-220		

Total number of Acres 22,050.65				
Survey designated	By Whom Surveyed	Date of Location	Amount of Survey	When Surveyed
Township 1 st 26 ^N Range 1 st 5 ^W Mer. Mich.	W. H. Brown	July 17 1853	22,050.65	1853
15-220	W. H. Brown	July 17 1853	22,050.65	1853

The above Map of Township 1st 26^N Range 1st 5^W Mer. Mich. is strictly conformable to the full notes of the survey thereof and the title of the same as assigned and approved by the Surveyor General of this State.

Surveyor General's Office
 Detroit Jan 25 1853

Seaver Chapman
 Surveyor