


Re Survey of
 Township 1st 2N. Range 1st 8 W. Mer. Mich.

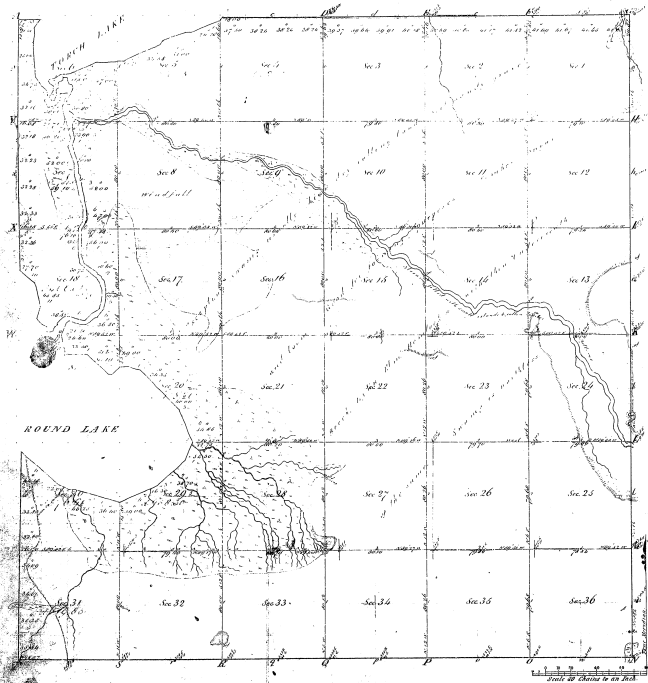

Boundaries of
 P. M. Section 1811 P. M. Section 1812 P. M. Section 1813

--	--	--	--

Mentions 18 in Sec 26

15-9

Note: The blue figures and marks show the portions of the old corners and lines

Total number of Acres 2140 264

Survey completed by	By whom Surveyed	Day of Month	Amount of Survey in Acres	Area Surveyed in Acres	Area Closed in the Survey in Acres
Friendship Line	Lucas & Lyon	April 19, 1851	11 74 23	11 74 23	11 74 23
Subdivisions	Lucas & Lyon	April 19, 1851	72 23 22	72 23 22	72 23 22

The above Map of Township 1st 2N Range 1st 8 W Mer. Mich. of the Township of Michigan, the accuracy of which is responsible to the full name of the survey being on file in this Office, which have been examined and approved.

Surveyor General's Office.
 Detroit Feb. 20th 1851

A. C. Smith
 Notary Public