


Township N<sup>o</sup> 58 N Range N<sup>o</sup> 29 W. Mer. Mich<sup>a</sup>

40-2802

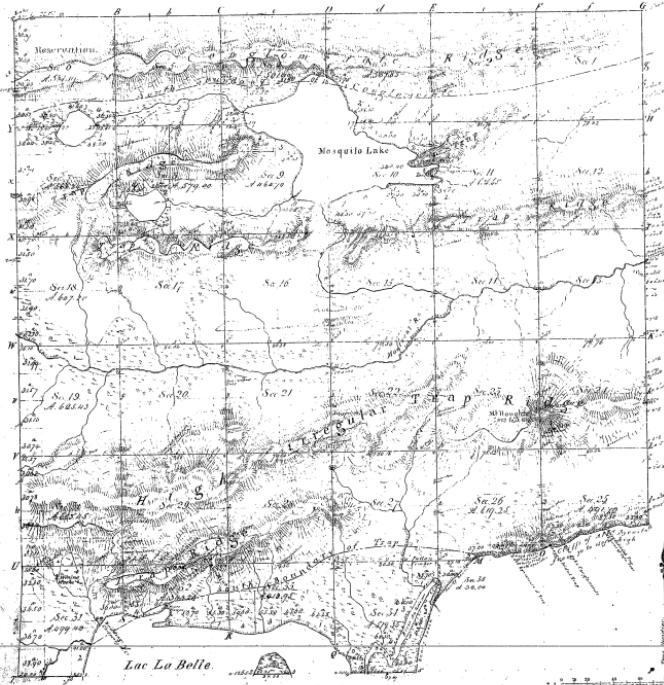

Section	Section Line	Section Line	Section Line	Section Line
Sec. 1				
Sec. 2				
Sec. 3				
Sec. 36				

Note.

Section 6 of the Township was reserved for Public purposes by the Resident Office of the Land Agent, now ad appears by the location of the same in the Surveyor's Office.

The boundaries will then permit a tract of land to be surveyed and put into the public domain.

Total number of acres 19,875.61

Survey Designated	Re When Surveyed	Date of Contract	Amount of Surveyor's Fee	When Surveyed	When Calculated


Township Line	At Lac La Belle	June 25, 1866	6. 19. 88	At. 25. 1866	1866
South Boundary	At the S.W. corner of Sec. 16	June 25, 1866	At. 25. 1866		
North Boundary	At the N.E. corner of Sec. 16	June 25, 1866	At. 25. 1866		

In above Map of Township N<sup>o</sup> 58, Part of Range 29<sup>th</sup> West of the Meridian, Michigan, the Surveyor's Office has been furnished with the field notes of the survey stored on file in this Office, which have been examined, and approved.

Surveyor General's Office  
Detroit, May 1, 1867  
L. C. Lyon, Secy.

40-200 ②

TOWNSHIP 58 NORTH, RANGE 29 WEST OF THE MICHIGAN MERIDIAN, MICHIGAN  
SURVEY OF THREE ISLANDS IN LAKE MEDORA, SECTION 10

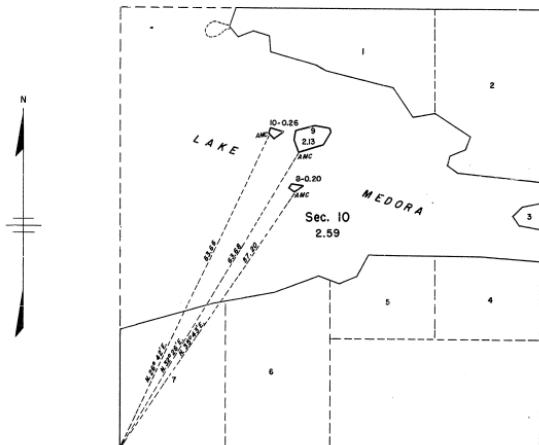

This plat represents the survey of three islands in Lake Medora which were not included in the original survey of the township which is represented on the plat approved September 1, 1847.

Surveyed by Norville E. Sharpe, Cadastral Surveyor, on August 22, 1885, under Special Instructions dated April 26, 1885 and Supplemental Special Instructions dated August 5, 1885, for Group No. Michigan.

0 5 10 20 40  
Scale in Chains  
Area Surveyed: 2.59 Acres

UNITED STATES DEPARTMENT OF THE INTERIOR  
BUREAU OF LAND MANAGEMENT  
Washington, D. C., February 17, 1956

This plat is strictly comparable to the original survey of the township, having been correctly executed in accordance with the requirements of law and the regulations of this Bureau, is hereby accepted.

For the Director

*John J. Harrington*  
Cadastral Engineering Staff Officer