


Township N. VI North, Range N. XI East of the Mer. (Mich. Ter.)

112

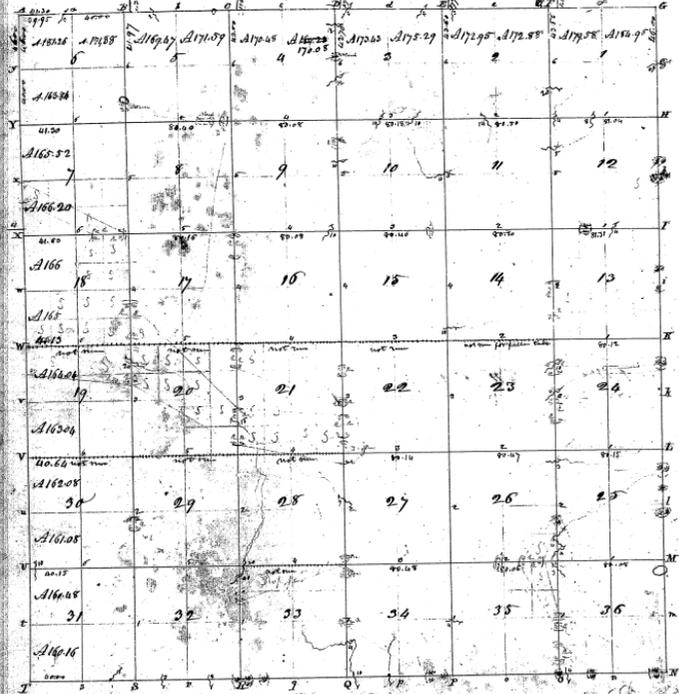

Average 23.25125 2 7/2

Consonant to a contract with and instruction from General S. J. P. Gannett of the United States
 bearing date the 10th of _____ I have examined here and through the above described
 Township and do hereby certify that it has such areas and bounds both natural and artificial as are
 represented on said plat and described in the title notes under through and returned with this plat, into the
 Surveyor General's office. Witness the hand of _____ of 24th 1875

Asst. Surveyor Genl.

27-19

27-19