


Township N. II North, Range N. VI East Mer. (Sketch)

18

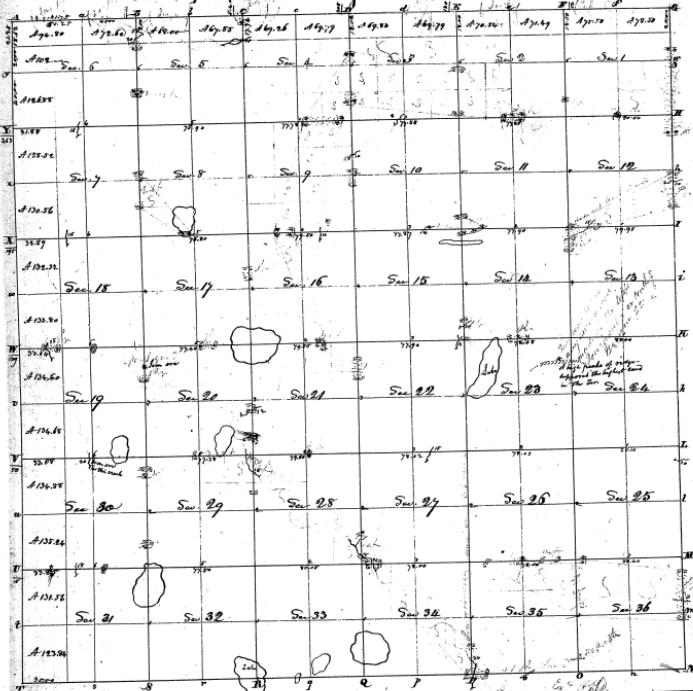

Presented to a Land Office in the Bureau of Land Management of the United States, bearing date the day of
 I have examined this set through the above Township, and do certify that it has no mistakes and is correct
 both naturally and artificially as are represented on said plat and described in the field notes made thereon, and is returned
 with the plat into the hands of the Surveyor General - Certified the 25 day of October 1823.

S. L. May Jr.

34

28

29