


Township N<sup>o</sup> 42 N Range N<sup>o</sup> 11 W

Mer. Mich.

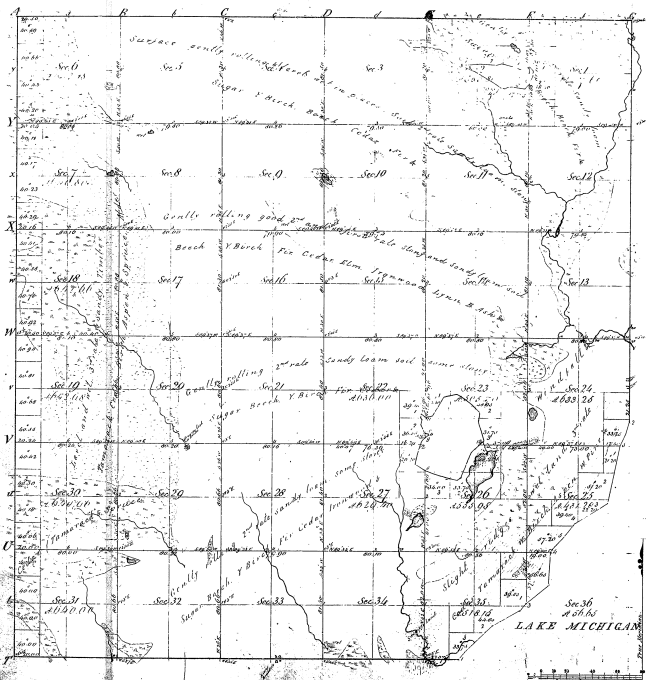

Section	Acres	Owner	Remarks
1			
2			
35-37

Total Contained  
7 1/2 Acres of Land

Total number of Acres 21837.20

Survey	By Whom Surveyed	Date of Contract	Amount of Survey	When Surveyed	Plan Drawn by
Primary	James Beard	July 28 1861	6 23 21	7 June 1864	
Subdivision	William Jacob	June 7 1869	66 79 56	27 Oct 1869	

The above Map of Township N<sup>o</sup> 42 N Range N<sup>o</sup> 11 W Mer. Mich. is a true and correct copy of the original as shown to me by the surveyor thereof, as filed in this Office, which have been examined and approved.  
Surveyor General's Office  
Charles A. Holt  
Detroit June 11 1870