


Township N.° 43. N. Range N.° 5 W. (Mer. Mich.)

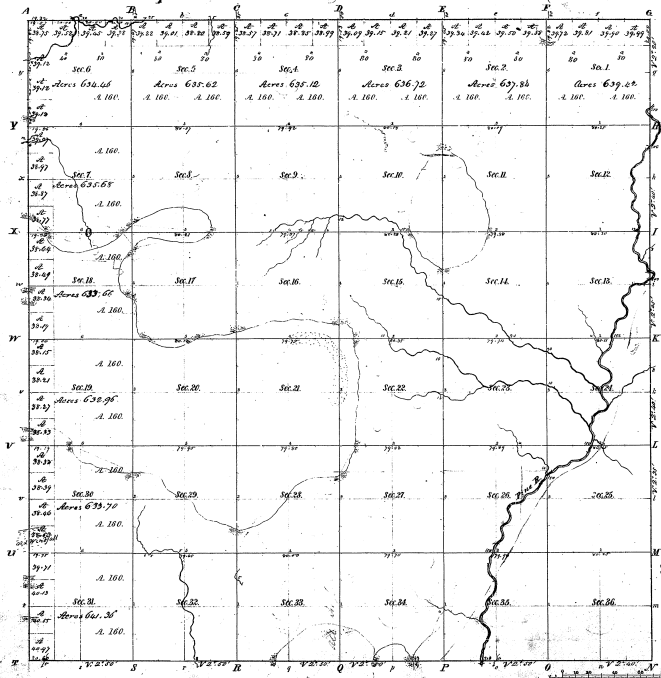

Mentions of					
Paul	Greene	1874	Paul	Greene	1874
34-39					

34-39

Total number of Acres 29,896.54				
Survey designated	By Whom Surveyed	Date of Conduct	When Surveyed	When made and in what name the Section was made
Common Land	Prud. School	April 17 1878	1878	1878
Subdivisions	Samuel N. Mullett	April 22 1878	1878	1878

The Law, Maps of Township N. 43 N., Range N. 5 West of the Principal Meridian, Michigan, as a study, measurable to the field notes of the survey, being on file in the office, which have been examined and approved.

Surveyor General's Office
 Lansing, Mich., Oct. 23 1898

Surveyed by *[Signature]*