


Township N. 1 North, Range N. 3 W. East of Mer. (Mich. 72)

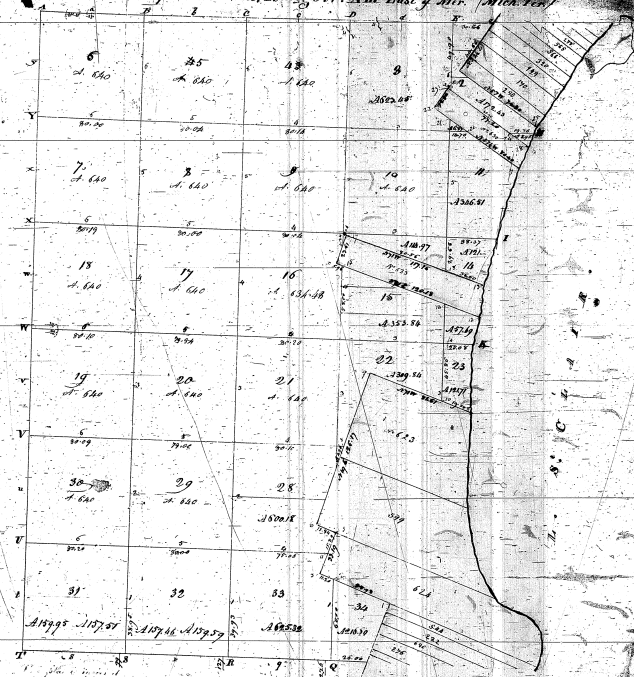

32-16-6


18799 18797  
18798 18796  
18795 18794

A true Copy from the Original on file in this Office

Township Records Office  
1879-1884

Richard L. ...


Township N. 1 north, Range H. 21 East, 10th Twp.

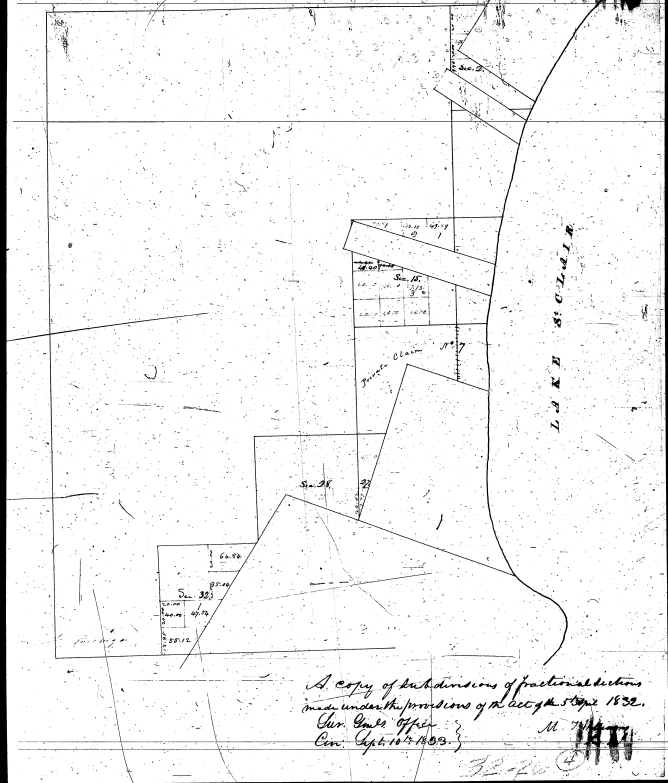

A copy of subdivisions of fractional sections  
 made under the provisions of Act No. 1832.  
 Can. Code of Prac. }  
 Civ. Apr. 16, 1893. } N. 11

32-26

N<sup>o</sup> 1 North Range N<sup>o</sup> XIII East of the ... Michigan Territory

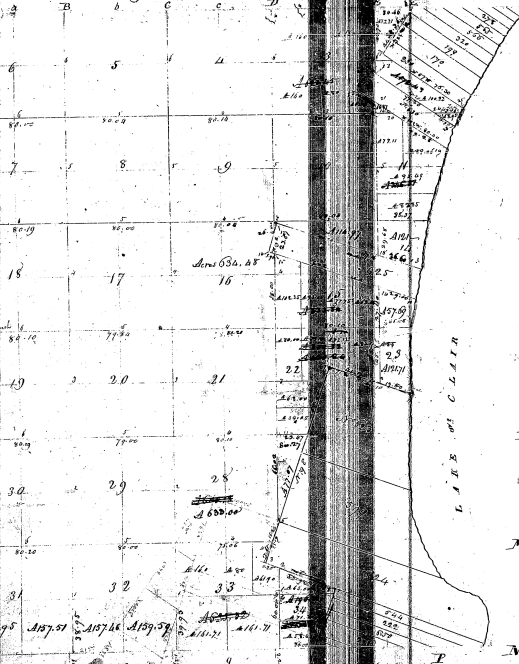

32-26

32-26

Pursuant to a contract with and instructions from Edward D. Hopper Esquire Surveyor General of the said State being date the twentieth day of November 1816 I have examined and surveyed the above described fractional ... and being satisfied that it had been ... on said Plot and do not ... in the ... made hereof and return with this plat ...

17th day of February 1818

William Preston Esq

4-207b  
(May 1954)

UNITED STATES  
DEPARTMENT OF THE INTERIOR  
BUREAU OF LAND MANAGEMENT  
WASHINGTON 25, D. C.

FSLR                      September 18, 1961

I hereby certify that the paper hereto attached is a photostatic copy of the plat of survey of the lands to which it refers, on file in this office and in my custody, namely: Township No. 1 North of Range No. 13 East of the Michigan Meridian, Michigan.

IN TESTIMONY WHEREOF I have hereunto subscribed my name and caused the seal of this office to be hereunto affixed, at the city of Washington, on the day and date above written.

*Deane E. Collier*

Certifying Officer

4-207b  
(May 1954)

UNITED STATES  
DEPARTMENT OF THE INTERIOR  
BUREAU OF LAND MANAGEMENT  
WASHINGTON 25, D. C.

FSLR                      September 18, 1961

I hereby certify that the paper hereto at-  
tached is a photostatic copy of the  
of survey of the lands to which it relates  
file in this office and in my custody  
Township No. 1 North of Range No. 13 East  
Michigan Meridian, Michigan.

IN TESTIMONY WHEREOF, I have hereunto sub-  
scribed my name and caused  
the seal of this office to  
be hereunto affixed, at the city of  
Washington, on the day and  
year above written.

*Robert E. Bell*  
\_\_\_\_\_  
Certifying Officer

With More Paper