


From S.W. Corner 251100' From S.W. Corner 17100'

**Township 1° 50' N. Range 1° 28' W. Mer. Mich.**

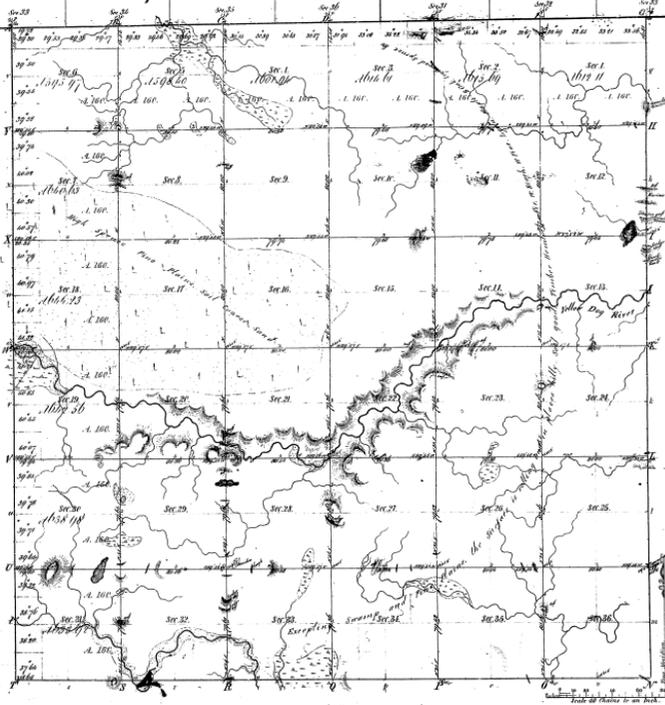

Measure of	Feet	Chains	Links
Scale Course 161° 12'			
Point Course 162° 12'			
Point Course 163° 12'			
Point Course 164° 12'			
Point Course 165° 12'			
Point Course 166° 12'			
Point Course 167° 12'			
Point Course 168° 12'			
Point Course 169° 12'			
Point Course 170° 12'			
Point Course 171° 12'			
Point Course 172° 12'			
Point Course 173° 12'			
Point Course 174° 12'			
Point Course 175° 12'			
Point Course 176° 12'			
Point Course 177° 12'			
Point Course 178° 12'			
Point Course 179° 12'			
Point Course 180° 12'			

39.20

Total number of Acres 22835.04

Survey designated	By whom surveyed	Date of Contract	Amount of Survey	When Surveyed	When paid for and how the Sur. was paid
Township Area	W. B. Hobbs, Sr.	April 27, 1853	22835.04	1853	22835.04
Individuals	Abner B. Hobbs, Jr.	April 27, 1853	59 55 50	1853	22835.04

The above Map of Township 1° 50' North of Range 1° 28' West of the Principal Meridian Michigan is strictly conformable to the field notes of the survey thereof on file in this office which have been examined and approved.

Surveyor General's Office  
 Detroit, Mich. of 1853

Charles F. Wells  
 Surveyor