


Township N<sup>o</sup> 33 N. Range N<sup>o</sup> 27 W. Mer. Mich.

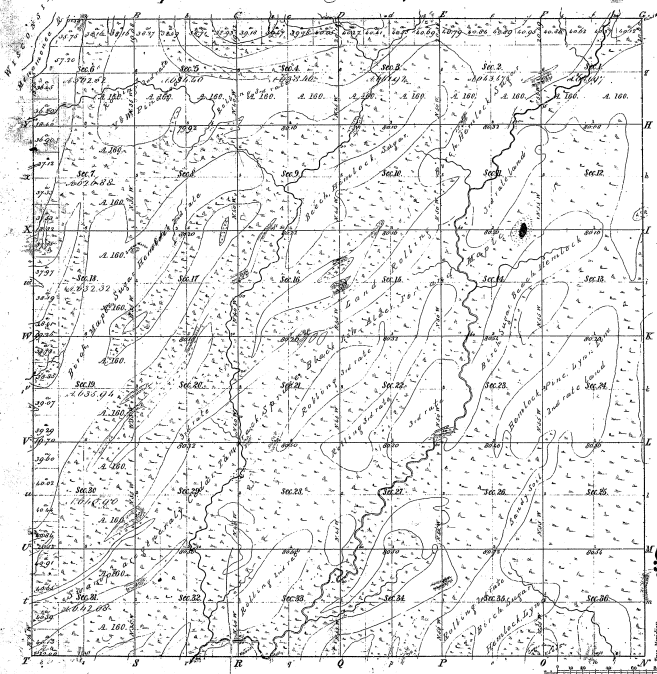

47-29

Measure of		Area		Area	
Feet	Course	Feet	Course	Feet	Course
47-29					
Total number of Acres 21040.00					

Survey Designated	By Whom Surveyed	Date of Definitive	Amount of Survey	When Surveyed	Range for and 1/2 Sec for Cont'g
Principal Meridian	W. H. Allen	Sept. 26, 1852	36 1/2 Sec	2 1/2 P.M. 1852	
Subdivisions	W. H. Allen	Sept. 26, 1852	36 1/2 Sec	2 1/2 P.M. 1852	

The above copy of Township N 33 N, Range N 27 W, Mer. Mich. is hereby referred to the field notes of the survey shown on file in this office, and these have been examined and approved and  
 Surveyor General's Office  
 Detroit, Dec. 20, 1868  
 Lucius Lyon, Surveyor General