


Township N<sup>o</sup> 11 N., Range N<sup>o</sup> 11 West Mer. (Mich.)

9-20-22

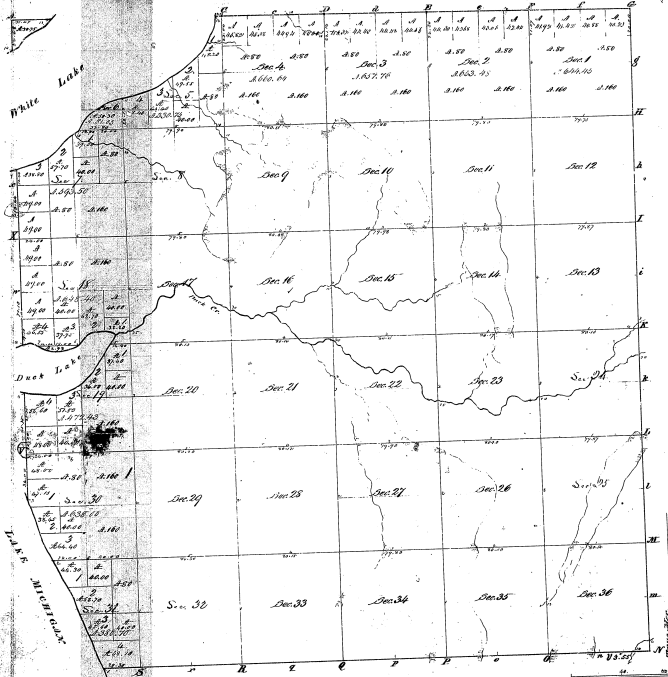

Account of Sales					
Sec.	Acres	W.D.	W.D.	Acres	W.D.
Dark Lake				White Lake	
4	794.0	23.00	1	1828.00	25.00
	8701.6	19.00	1	1828.00	25.00
	1840.0	20.00	1	1828.00	25.00
	2065.0	21.00			
5	1281.6	6.00	2	1828.00	25.00
	1538.00	6.00			
	7942.00	6.00			
	1025.00	12.00			
	1238.00	11.50			
6	1529.00	11.00			
	1879.00	11.50			
7	1872.00	6.00			
8	1794.00	6.00			
White Lake					
10	1640.00	11.50			
	1828.00	25.00			
	1840.00	20.00			
	1872.00	6.00			
	1828.00	25.00			
11	1872.00	6.00			
	1872.00	6.00			
12	1872.00	6.00			
	1872.00	6.00			
13	1872.00	6.00			
	1872.00	6.00			
14	1872.00	6.00			
	1872.00	6.00			
15	1872.00	6.00			
	1872.00	6.00			
16	1872.00	6.00			
	1872.00	6.00			
17	1872.00	6.00			
	1872.00	6.00			
18	1872.00	6.00			
	1872.00	6.00			
19	1872.00	6.00			
	1872.00	6.00			
20	1872.00	6.00			
	1872.00	6.00			
21	1872.00	6.00			
	1872.00	6.00			
22	1872.00	6.00			
	1872.00	6.00			
23	1872.00	6.00			
	1872.00	6.00			
24	1872.00	6.00			
	1872.00	6.00			
25	1872.00	6.00			
	1872.00	6.00			
26	1872.00	6.00			
	1872.00	6.00			
27	1872.00	6.00			
	1872.00	6.00			
28	1872.00	6.00			
	1872.00	6.00			
29	1872.00	6.00			
	1872.00	6.00			
30	1872.00	6.00			
	1872.00	6.00			
31	1872.00	6.00			
	1872.00	6.00			
32	1872.00	6.00			
	1872.00	6.00			
33	1872.00	6.00			
	1872.00	6.00			
34	1872.00	6.00			
	1872.00	6.00			
35	1872.00	6.00			
	1872.00	6.00			
36	1872.00	6.00			
	1872.00	6.00			

9-22

Sheet number of sales 21, 26, 44

Original	Amended	Original	Amended
1872	1872	1872	1872
1872	1872	1872	1872
1872	1872	1872	1872
1872	1872	1872	1872

This above map of Township N<sup>o</sup> 11 North, of Range N<sup>o</sup> 11 West of the Meridian Michigan is the only conformable to the field notes of the survey thereof on file in this office which have been examined & approved.

Surveyor General's Office  
Ann Arbor, Mich. 25/1927

C. P. R. Ing  
S. J. S.