


Township N° 55 N. Range N° 54 W. Mer. Mich.

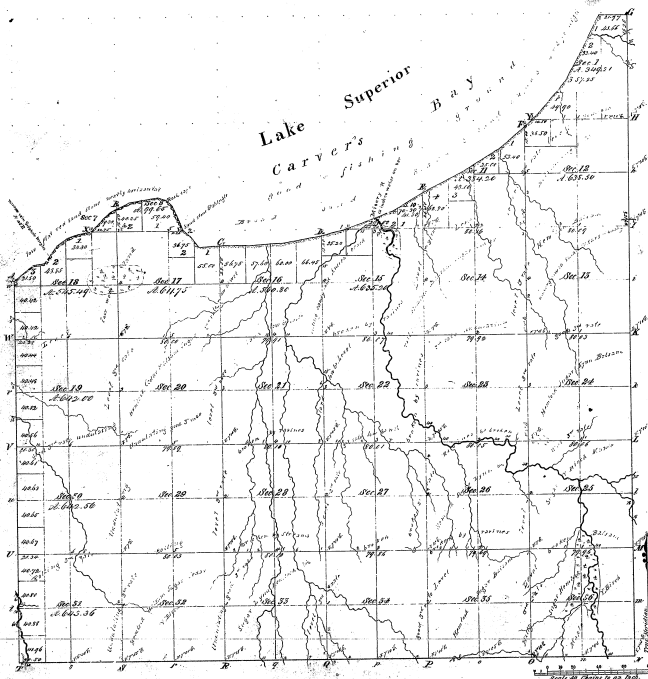

Mentions of											
Past	Present	1788	1791	1794	1797	1800	1803	1806	1809	1812	1815

Total number of acres 16722.26

Section designated	By whom surveyed	Date of Survey	Amount of Acres	When surveyed	When changed to the acre and half act
Surveying town	Wm. C. Pennington	June 23, 1826	16,742.62	June 21, 1827	
Subsections	James S. Bennett	June 23, 1846	52.75	June 23, 1846	

The above Map of Township N° 55 North, of Range N° 54 West of the Principal Meridian is a correct and accurate representation of the same as filed in this Office, which have been examined and approved.

Charles General Officer  
Detroit, Oct. 16, 1827

41-16

41-16