


Township N° IV North Range N° XVI East of Meridian Township

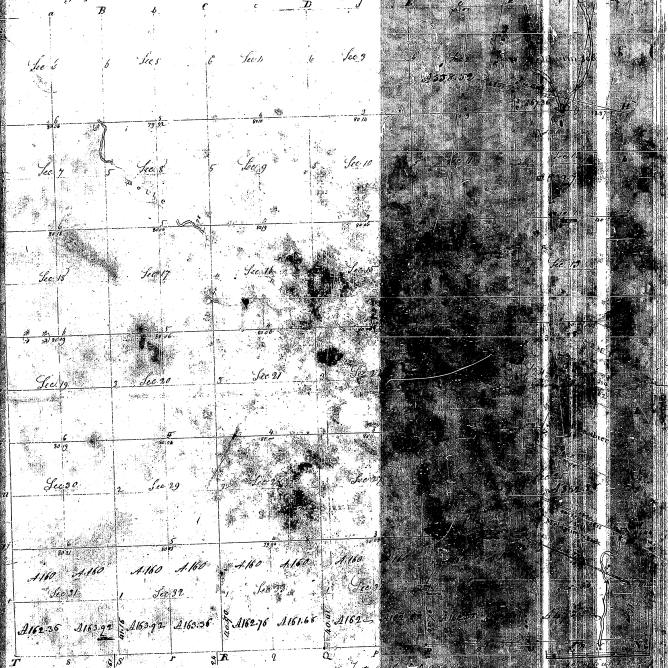

Pursuant to a Contract with and Authority of the
 General of the United States bearing date the 28th day of
 and surveyed the above described Township (and
 first natural and original as are represented on said
 and placed with this State into the Survey General

26-34
 26-34