


Township N^o VII south, Range N^o XV east of 1st Meridian (T^hird 5th) 155

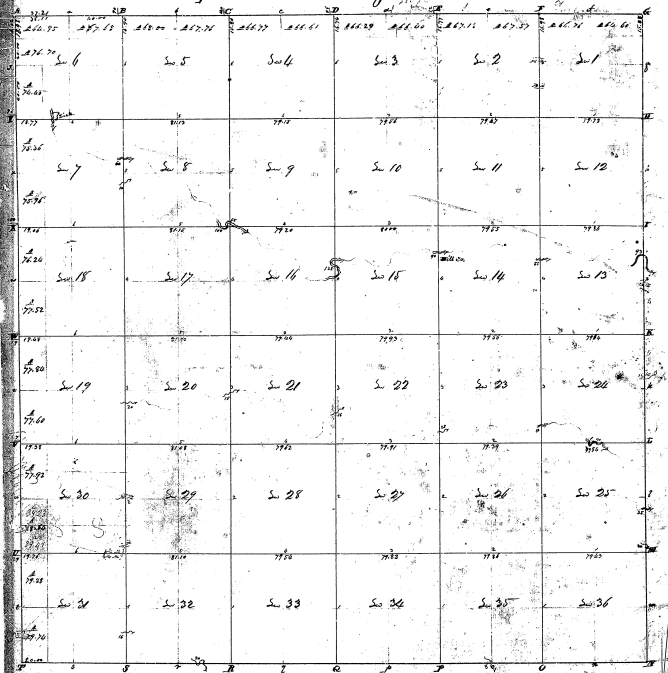

26-18
26-18

Compared to a plat with and instructions from Cassius S. Johnson of General of the Indian title, bearing date the 17th of June 1854, and showing the same more fully, and the title thereunto, and the same, both as to the land and the title, as are represented on said plat and instructions, the same were made, checked and returned into this office with the foregoing general office, & bearing the same of said year.

24th of 1854

Lucius Lyon, C^l