


Township N. 18 North, Range N. W. East Mer. (Mich. Ter.)

157

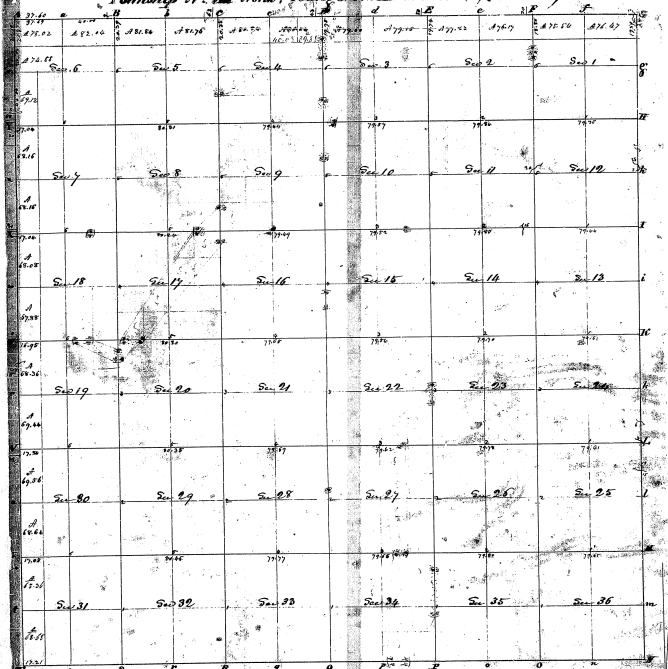

26-13

26-13

Pursuant to a contract with and instructions from Board of Public Lands of the United States, having deposited the map
 I have examined said map and bearings the above described township, and do hereby certify that it has been made
 and bound both true and correct as far as represented on said map, and described in the foregoing words, things and
 manner in the said contract, and that the same were made between the 1st day of April 1822

Lucius Reynolds

See p. 80 of 1822