


Township N° 9 N, Range N° 14 East Mer. (Mich.)

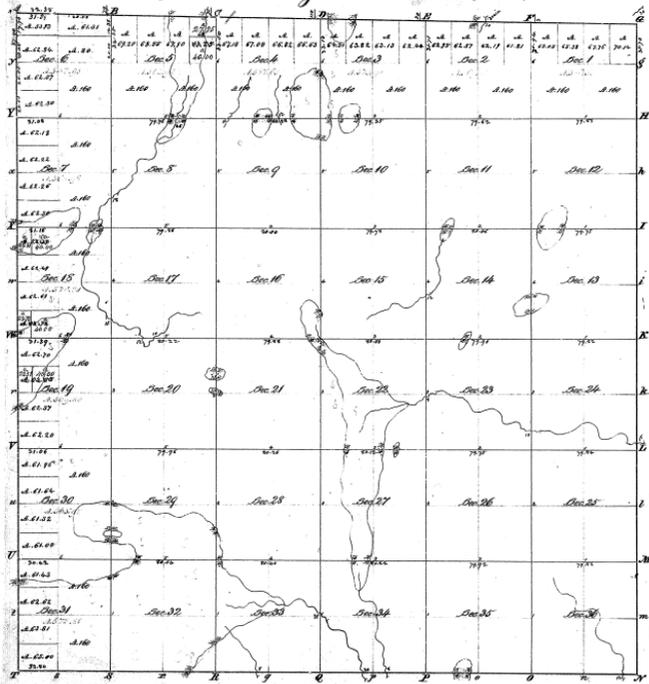

26-9

26-9

Scale 1 inch = 1/2 mile

Surveyed by whom	John C. Smith
Approved by whom	John C. Smith
Date of survey	25. 25. 78
Section	102
Volume	102
Page	102

The above Map of Township N° 9 North, of Range N° 14 East, of the Michigan Territory, is hereby confirmed to the full extent of the Survey thereof by the Office, to which has been transmitted a duplicate of the original Survey Office.

J. M. Williams
 Surveyor General, Mich. 25. 25. 78