


Township N^o 12 N Range N^o 13 E Mer. Mich.

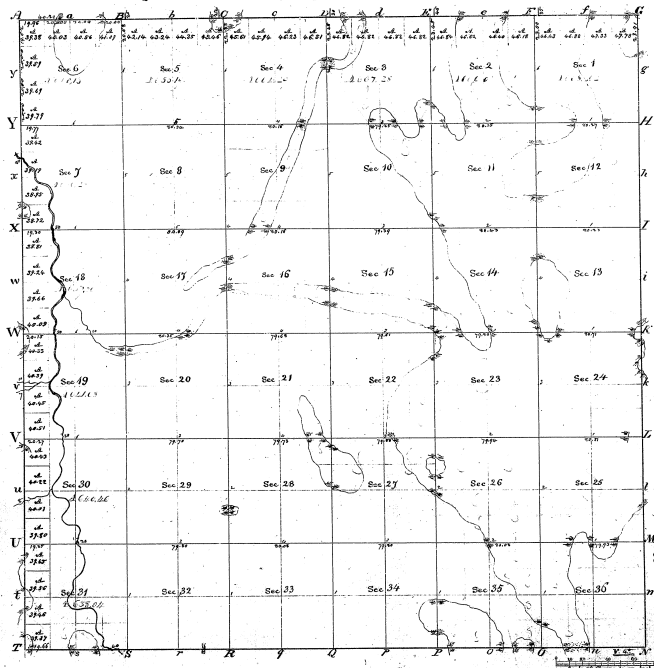

Meridian of		Point		Corner		Point		Corner		Point		Corner	

25-32

25-32

Total number of Acres 25,155.0

Survey designated	By Whom Surveyed	Date of Contract	Amount of Survey	When Surveyed	When Made and as to the Section
Subdivision	A. Bond	11. Aug. 1836	25 00 00	1836	1836
Township base	Henry Steele	25. 26. 1833	25. 00. 00	1833	1833

The above Map of Township N^o 12 North, Range N^o 13 East of the Principal Meridian, Mich. is a true and correct copy of the field notes of the survey thereof on file in this Office, which have been examined and approved.

Surveyor General's Office,
Ann Arbor, Mich. 20 1851

M. T. Williams
Surveyor