


Township 15 N. Range 16 W. Ver. Mich.

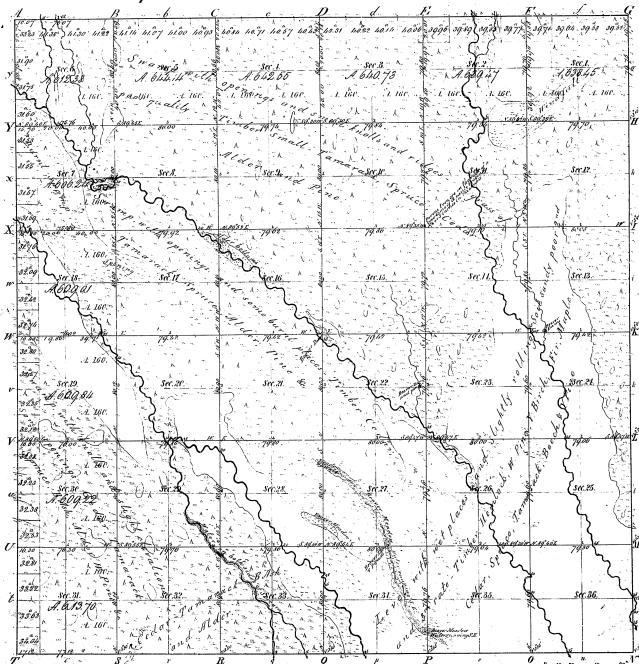

Total number of Acres 22,806.73

Township designated	By whom surveyed	Date of Contract	Amount of Survey	When Surveyed	Value of land at date of Survey
Township 15 N.	W. H. Woodruff	Sept. 4 1834	36 36 36	8 th Decr 1835	
Subdivision	Wilderness Cove	Apr. 20 1850	36 36 36	2 nd Decr 1850	

The above map of Township 15 N. Range 16 W. West of the Principal Meridian Michigan is hereby confirmed to the field notes of the survey by me and it is the office which has been examined and approved

George S. Smith
 District Surveyor 1851

Recorder of

Book	Page	Book	Page
37-11			

37-19