


Township No 19 N, Range No 7 East, Mer Mich.

71 241-30

2430

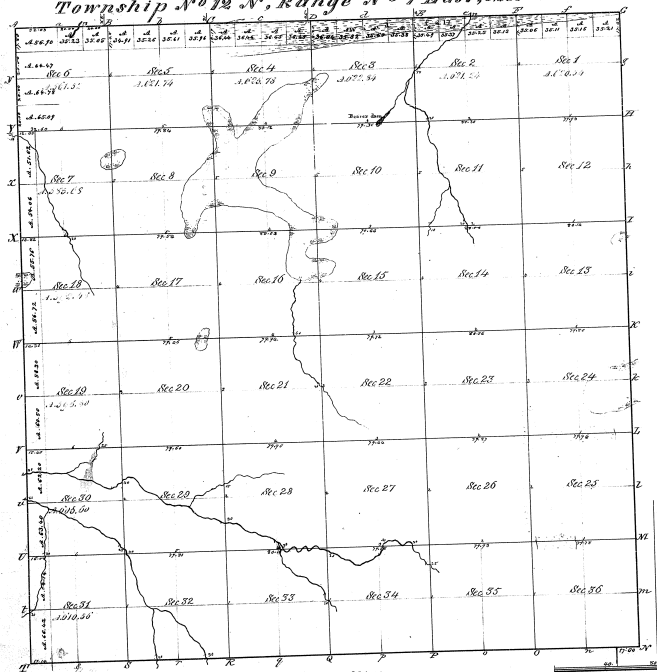

Survey	Original	By whom surveyed	Date of contract	No. of acres	Area surveyed	Area returned
W. H. H. H. H.	W. H. H. H. H.	W. H. H. H. H.	1853	1750	1750	1750
W. H. H. H. H.	W. H. H. H. H.	W. H. H. H. H.	1853	1750	1750	1750
W. H. H. H. H.	W. H. H. H. H.	W. H. H. H. H.	1853	1750	1750	1750

The above Map, of Township No 19 North of Range No 7 East of the Principal Meridian, Michigan Territory, is hereby confirmed to the true owner of the Survey thereof on file in this Office, which has been examined & approved.

Surveyor General's Office
 Detroit, Mich. 30th Dec 1853

M. T. Williams
 Sur. Genl