


Resurvey
Township 33 N. Range 4 E. Mich.

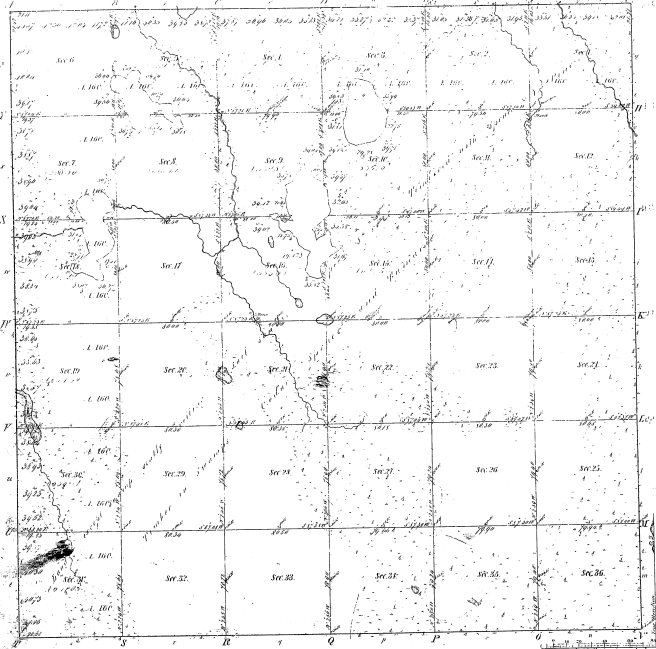

Meander of
 Public Grounds 1874 Public Grounds 1874 Public Grounds 1874

13

70-13

Standard Meridian 74th

Total number of Acres 2557.16

Survey Extended	By Whom Surveyed	Date of Contment	Amount of Acres	How Surveyed	How Placed and set in the Section
Traverse	John Holbrook	June 1874	2557.16	3 ^d Class 1140	
Indorsement	By John Holbrook	Sept 1874	2557.16	3 ^d Class 1140	

The above Survey Township 33 North Range 4 East of the Michigan Meridian 74th Michigan is truly conformable to the field notes of the survey thereon, the file in the office and has been examined and approved.

Surveyor General's Office
 Detroit March 16 1874

David Chapman
 Surveyor

Correct Copy made
 by J. C. [unclear]