


Resurvey
 Township 12 S., R. 2 E., Mer. Mich.

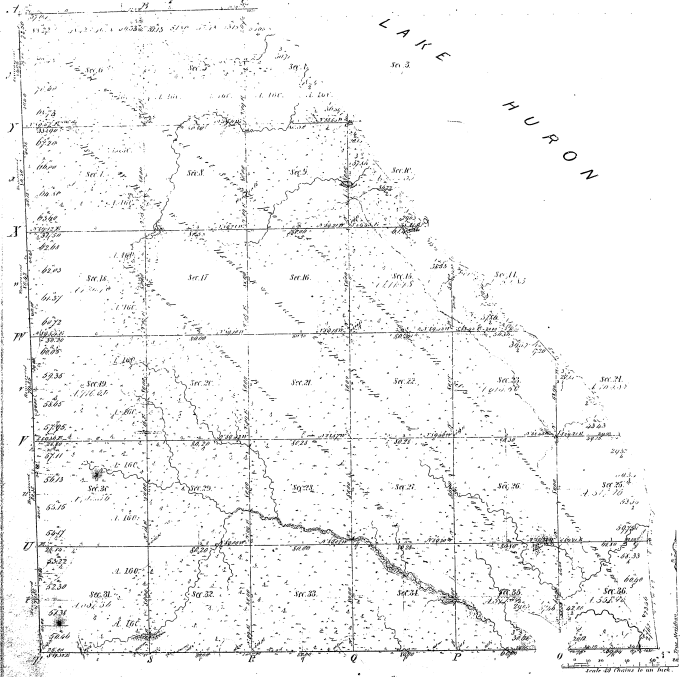

Boundaries of
 P. M. Co. Sec. 1, 2, 3, 4, 5, 6, 7, 8, 9, 10, 11, 12, 13, 14, 15, 16, 17, 18, 19, 20, 21, 22, 23, 24, 25, 26, 27, 28, 29, 30, 31, 32, 33, 34, 35, 36

1130

19-30

Township	Range	Section	By Whom Surveyed	Date of Survey	Amount of Survey	When Surveyed	When Made and by Whom
12 S.	2 E.	1	Geo. W. Cannon	Oct. 5 th 1860	36 3/4 Acs	2 nd Decr 1860	
		2	Geo. W. Cannon	Oct. 5 th 1860	36 3/4 Acs	2 nd Decr 1860	

The above map of Township 12 S., R. 2 E., Mer. Mich. is a true and correct copy of the original survey on file in the Office, which has been examined and approved.
 Surveyor General's Office,
 Detroit, Michigan, 23 1860

Sandra Chapman