


**LEGEND**

- Sand and Gravel
- Silt and Muck
- Rock
- VEGETATION**
- I Emergent
- T Floating
- Submergent
- SHORE FEATURES**
- Cottage
- W Marsh
- W Wooded
- P Pasture or cleared land
- STATIONS**
- ③ Vegetation
- △ Temp and chem. analysis
- ▲ Plankton
- ▲ Temp., chem., plankton
- ⊠ Bottom sample
- ⊗ Fish sample
- #, # Brush shelters

⊠ SEVEN GROUPS OF SHELTERS, 8 PER GROUP, AND ONE GROUP OF SIX SHELTERS, INSTALLED IN FALL OF 1948.

#, # SEVENTEEN GROUPS OF SHELTERS, 8 PER GROUP, INSTALLED IN FALL OF 1949.

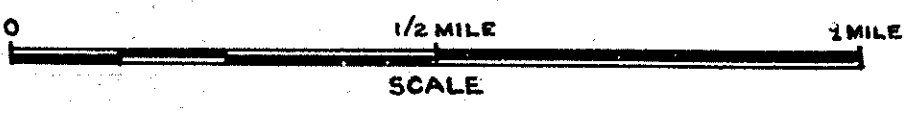

INSTITUTE FOR FISHERIES RESEARCH  
 DIVISION OF FISHERIES MICHIGAN CONSERVATION DEPT  
 LAKE INVENTORY MAP  
**LAKE MICHIGAMME**  
 AREA 4360 ACRES  
 SOUNDINGS JANUARY, 1938  
 OUTLINE FROM AERIAL SURVEY BY AAA INVENTORY 8/16-9/2/38  
 MARQUETTE COUNTY 47-48 N 30-31 W