


Township N. IV North, Range N. XIV West Mer. (Mic. Tor.)

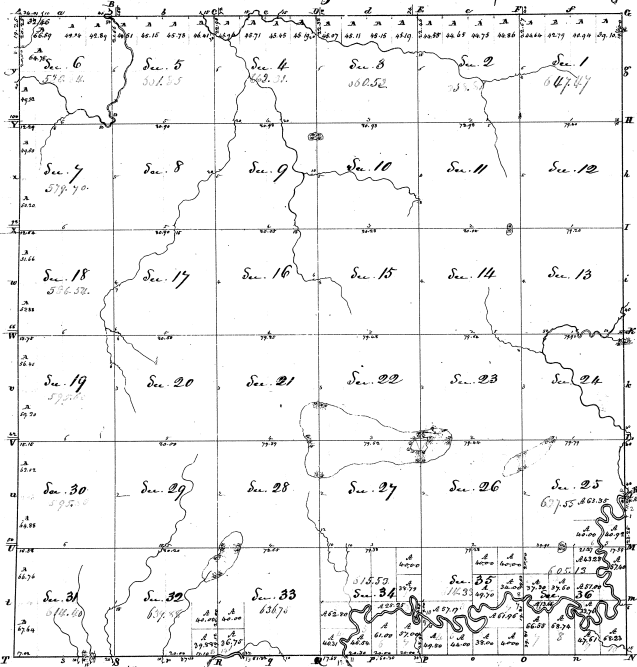

Survey of	12.30.18	12.30.18	12.30.18
By whom surveyed	Wm. H. H. H.	Wm. H. H. H.	Wm. H. H. H.
Approved	12.30.18	12.30.18	12.30.18
By whom approved	Wm. H. H. H.	Wm. H. H. H.	Wm. H. H. H.
Approved	12.30.18	12.30.18	12.30.18
By whom approved	Wm. H. H. H.	Wm. H. H. H.	Wm. H. H. H.

The above list of land is a true and correct copy of the original list of land in the office, which has been examined and approved.  
 Surveyor General's Office  
 Cincinnati, Oct. 11th 1833  
 N. T. Williams  
 Sur. Gen.

Section	Acres	Section	Acres	Section	Acres
1	647.87	13	677.31	25	677.31
2	677.31	14	677.31	26	677.31
3	677.31	15	677.31	27	677.31
4	677.31	16	677.31	28	677.31
5	677.31	17	677.31	29	677.31
6	677.31	18	677.31	30	677.31
7	677.31	19	677.31	31	677.31
8	677.31	20	677.31	32	677.31
9	677.31	21	677.31	33	677.31
10	677.31	22	677.31	34	677.31
11	677.31	23	677.31	35	677.31
12	677.31	24	677.31	36	677.31