


T 8 South, R. 18 West Mich

1-34

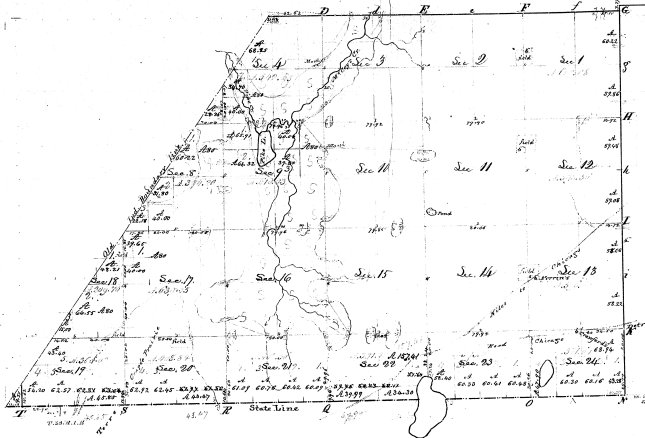

Original of Sects	
Sec 1	1.00
Sec 2	1.00
Sec 3	1.00
Sec 36	1.00


1-34

... 18 2000 ...

Section	18th March 20th July 1885	3. 11. 66	17. 7. 1883	17. 7. 1885
Sub-section	18th March	22. 22. 22		

The above map of Township 8 South, Range 18 West, Mich. is strictly conformable to the field notes files being found on file in this office which have been examined & approved by the Board of Commissioners.

Township N. VIII south, Range N. XVIII West Mer. (M.C. Ter.)

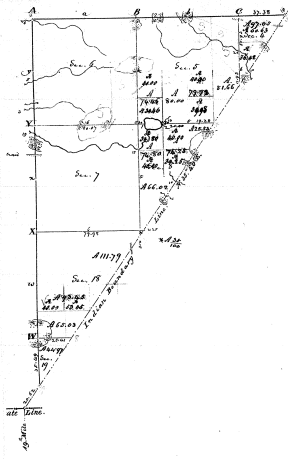

1-34

Section 6		
Section	Area	Ac.
ft. Sec. 4	27	0.0
Sec. 5	220	
6.2 S.E.	21	66
Sec. -	79	98
6.2 S.W.	80	
Sec. -	74	66
Sec. 6	640	
Sec. 7	640	
6.2 S.E. 8	25	53
6.2 S.W.	74	25
Sec. -	74	80
ft. S.W.	66	02
ft. S.W. 7	0	35
ft. S.W. 8	111	79
Sec. -	160	
6.2 S.W.	93	05
Sec. -	65	03
ft. Sec. 19	44	97
	26	99

1-34-A

Surveyed November 3, 1929 - by Edwin Lyon, C.S.

Scale 60 Ch. to an inch