


Township N. VIII South, Range N. VIII West (Misc. Twp.)

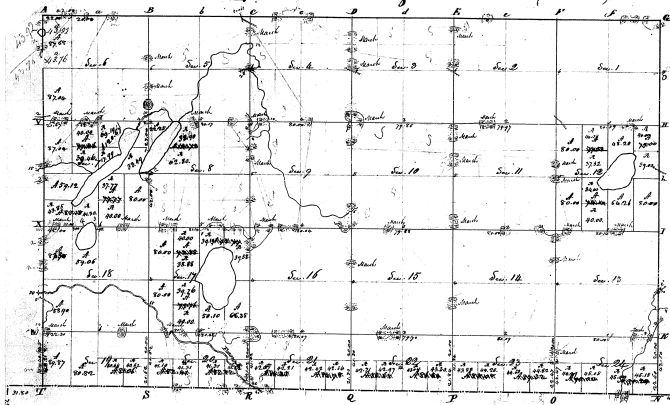

Surveyed in May 1825 by Robert Black Chief S. & L.

Boundaries			Boundaries		
Acres	Perches	Value	Acres	Perches	Value
Sec. 1	640	80	Sec. 18	640	80
Sec. 2	640	80	Sec. 19	640	80
Sec. 3	640	80	Sec. 20	640	80
Sec. 4	640	80	Sec. 21	640	80
Sec. 5	640	80	Sec. 22	640	80
Sec. 6	640	80	Sec. 23	640	80
Sec. 7	640	80	Sec. 24	640	80
Sec. 8	640	80	Sec. 25	640	80
Sec. 9	640	80	Sec. 26	640	80
Sec. 10	640	80	Sec. 27	640	80
Sec. 11	640	80	Sec. 28	640	80
Sec. 12	640	80	Sec. 29	640	80
Sec. 13	640	80	Sec. 30	640	80
Sec. 14	640	80	Sec. 31	640	80
Sec. 15	640	80	Sec. 32	640	80
Sec. 16	640	80	Sec. 33	640	80
Sec. 17	640	80	Sec. 34	640	80
Sec. 18	640	80	Sec. 35	640	80
Sec. 19	640	80	Sec. 36	640	80
Sec. 20	640	80			
Sec. 21	640	80			
Sec. 22	640	80			
Sec. 23	640	80			
Sec. 24	640	80			
Sec. 25	640	80			
Sec. 26	640	80			
Sec. 27	640	80			
Sec. 28	640	80			
Sec. 29	640	80			
Sec. 30	640	80			
Sec. 31	640	80			
Sec. 32	640	80			
Sec. 33	640	80			
Sec. 34	640	80			
Sec. 35	640	80			
Sec. 36	640	80			
Total	23040	2880			

A-35