


Township VIII south, Range VIII west, (West Pa.)

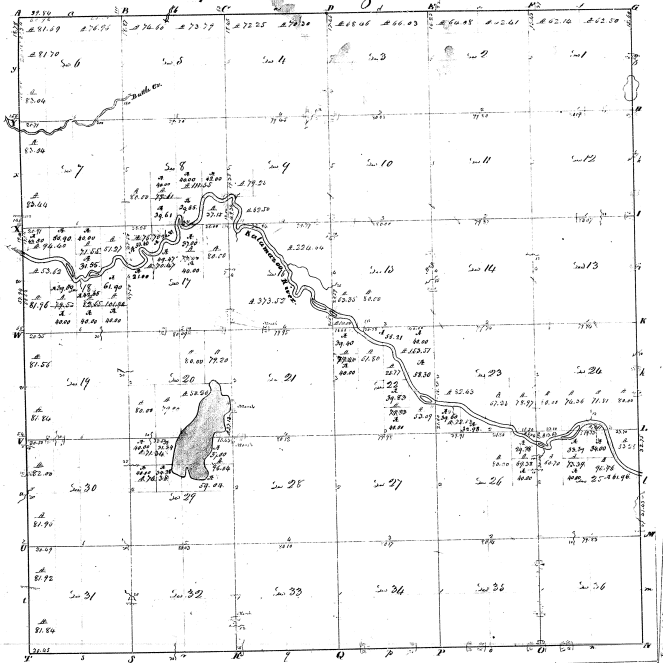

Surveyed in March & April 1828, by Sigmund Sibley D. C.

Sigmund Sibley
Surveyor General

3-17

31.2 B	1	70	80	10	20
32	80				
31.2 B	2	80	70	10	20
32	80				
32	70	80	5 E	10	20
31.2 B	3	80	40	10	20
32	80				
31.2 B	4	80	10	20	30
32	80				
31.2 B	5	80	10	20	30
32	80				
31.2 B	6	80	10	20	30
32	80				
31.2 B	7	80	10	20	30
32	80				
31.2 B	8	80	10	20	30
32	80				
31.2 B	9	80	10	20	30
32	80				
31.2 B	10	80	10	20	30
32	80				
31.2 B	11	80	10	20	30
32	80				
31.2 B	12	80	10	20	30
32	80				
31.2 B	13	80	10	20	30
32	80				
31.2 B	14	80	10	20	30
32	80				
31.2 B	15	80	10	20	30
32	80				
31.2 B	16	80	10	20	30
32	80				
31.2 B	17	80	10	20	30
32	80				
31.2 B	18	80	10	20	30
32	80				
31.2 B	19	80	10	20	30
32	80				
31.2 B	20	80	10	20	30
32	80				
31.2 B	21	80	10	20	30
32	80				
31.2 B	22	80	10	20	30
32	80				
31.2 B	23	80	10	20	30
32	80				
31.2 B	24	80	10	20	30
32	80				
31.2 B	25	80	10	20	30
32	80				
31.2 B	26	80	10	20	30
32	80				
31.2 B	27	80	10	20	30
32	80				
31.2 B	28	80	10	20	30
32	80				
31.2 B	29	80	10	20	30
32	80				
31.2 B	30	80	10	20	30
32	80				
31.2 B	31	80	10	20	30
32	80				
31.2 B	32	80	10	20	30
32	80				
31.2 B	33	80	10	20	30
32	80				
31.2 B	34	80	10	20	30
32	80				
31.2 B	35	80	10	20	30
32	80				
31.2 B	36	80	10	20	30
32	80				

3-17

3-17
33 600
36 600
35 600
34 600
