



Township N<sup>o</sup> 44 N. Range N<sup>o</sup> 2 E.

Mer. Mich.

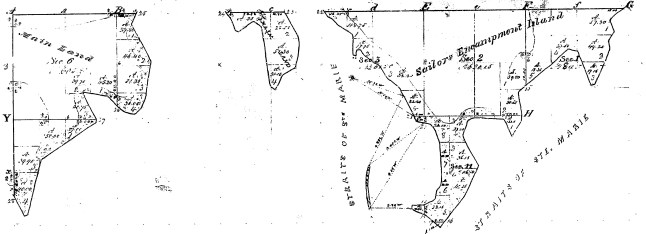

MUNUSKONG BAY.

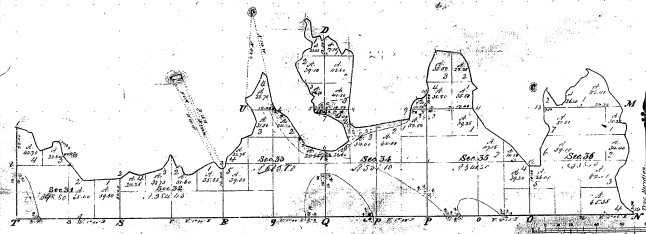

Masters of							
Part	Course	Dist	Part	Course	Dist	Part	Course
33-11							
33-11							

Total number of Acres 5,746.34

Survey designated	By Whom Surveyed	Date of Contract	Amount of Survey in Acres	When Surveyed	When Closed in the Office
Original	John A. Smith	July 1st 1854	5,746.34	1854	1854
Revised	John A. Smith	July 1st 1854	5,746.34	1854	1854

The above Map of Township N<sup>o</sup> 44 North of Range N<sup>o</sup> 2 East of the Meridian of Michigan is a true and correct copy of the survey made by me in the Office and is approved by me as Surveyor General.

Surveyed in the Office of the Surveyor General  
 Surveyed in the Office of the Surveyor General  
 Surveyed in the Office of the Surveyor General

PLAT OF PINE ISLAND  
IN MUNUSONG BAY, ST. MARY'S RIVER,  
in Sec. 29, T. 44N., R. 2E., Mich. Mer.,

MICHIGAN.

Surveyed by Francis McKinney, U.S. Transitman, June 25-29, 1914,  
under special instructions from the Com<sup>r</sup> of the G.L.O., dated May 27, 1914.


Scale, 10 chs. to an inch.


Area of lands surveyed = 3.56 acres, not shown upon the  
plat approved Dec. 24, 1915.

Areas of previously surveyed lands not shown.


Department of the Interior,  
General Land Office,  
Washington, D.C., May 24, 1915.

The accompanying plat of Pine Island in Munusong Bay, St. Mary's  
River, in Sec. 29, T. 44N., R. 2E., Mich. Mer., Michigan, is strictly conform-  
able to the field notes of the survey thereof, on file in this office, which  
have been examined and approved.

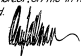  
Commissioner and ex officio  
U.S. Surveyor General for Michigan.

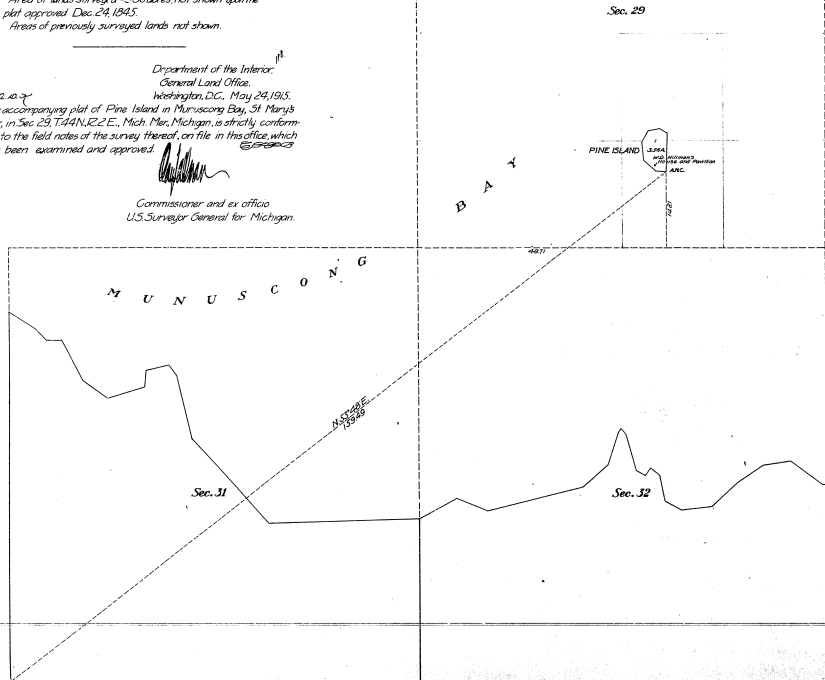

TOWNSHIP 44 NORTH, RANGE 2 EAST, OF THE MICHIGAN MERIDIAN, MICHIGAN.  
SURVEY OF ISLANDS

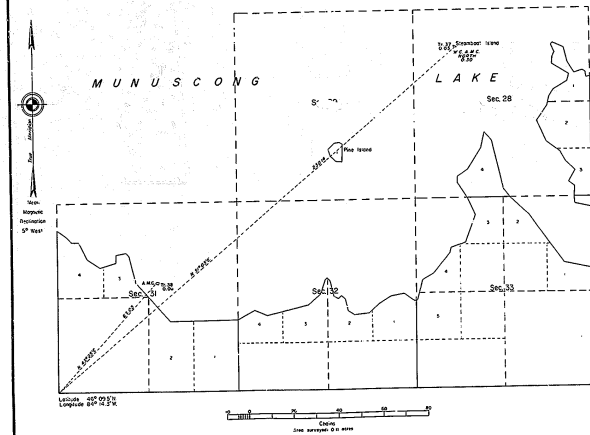

A history of surveys is contained in the field notes.

This plat represents the survey of two islands in Munuscong Lake, T. 44 N., R. 2 E., Michigan Meridian, Michigan.

Except as indicated herein, the lottings and areas are as shown on the plats approved December 24, 1845, and May 24, 1913.

Survey executed by Gary L. Kratz, Cadastral Surveyor, beginning May 23, 1976, and completed July 31, 1976, pursuant to Special Instructions dated June 3, 1977, for Group No. 78, Michigan.

UNITED STATES DEPARTMENT OF THE INTERIOR  
BUREAU OF LAND MANAGEMENT  
Denver, Colorado November 19, 1981

This plat is strictly conformable to the approved field notes, and the survey, having been correctly executed in accordance with the requirements of law and the regulations of this Bureau, is hereby accepted.

For the Director

Acting Chief, Cadastral Survey  
Examination and Approval Staff

33-11