


Township N<sup>o</sup> 46 N. Range N<sup>o</sup> 1 West Mer. Michigan

Meridian 1842  
 Pole Courses 1842 Pole Courses 1842

21-11

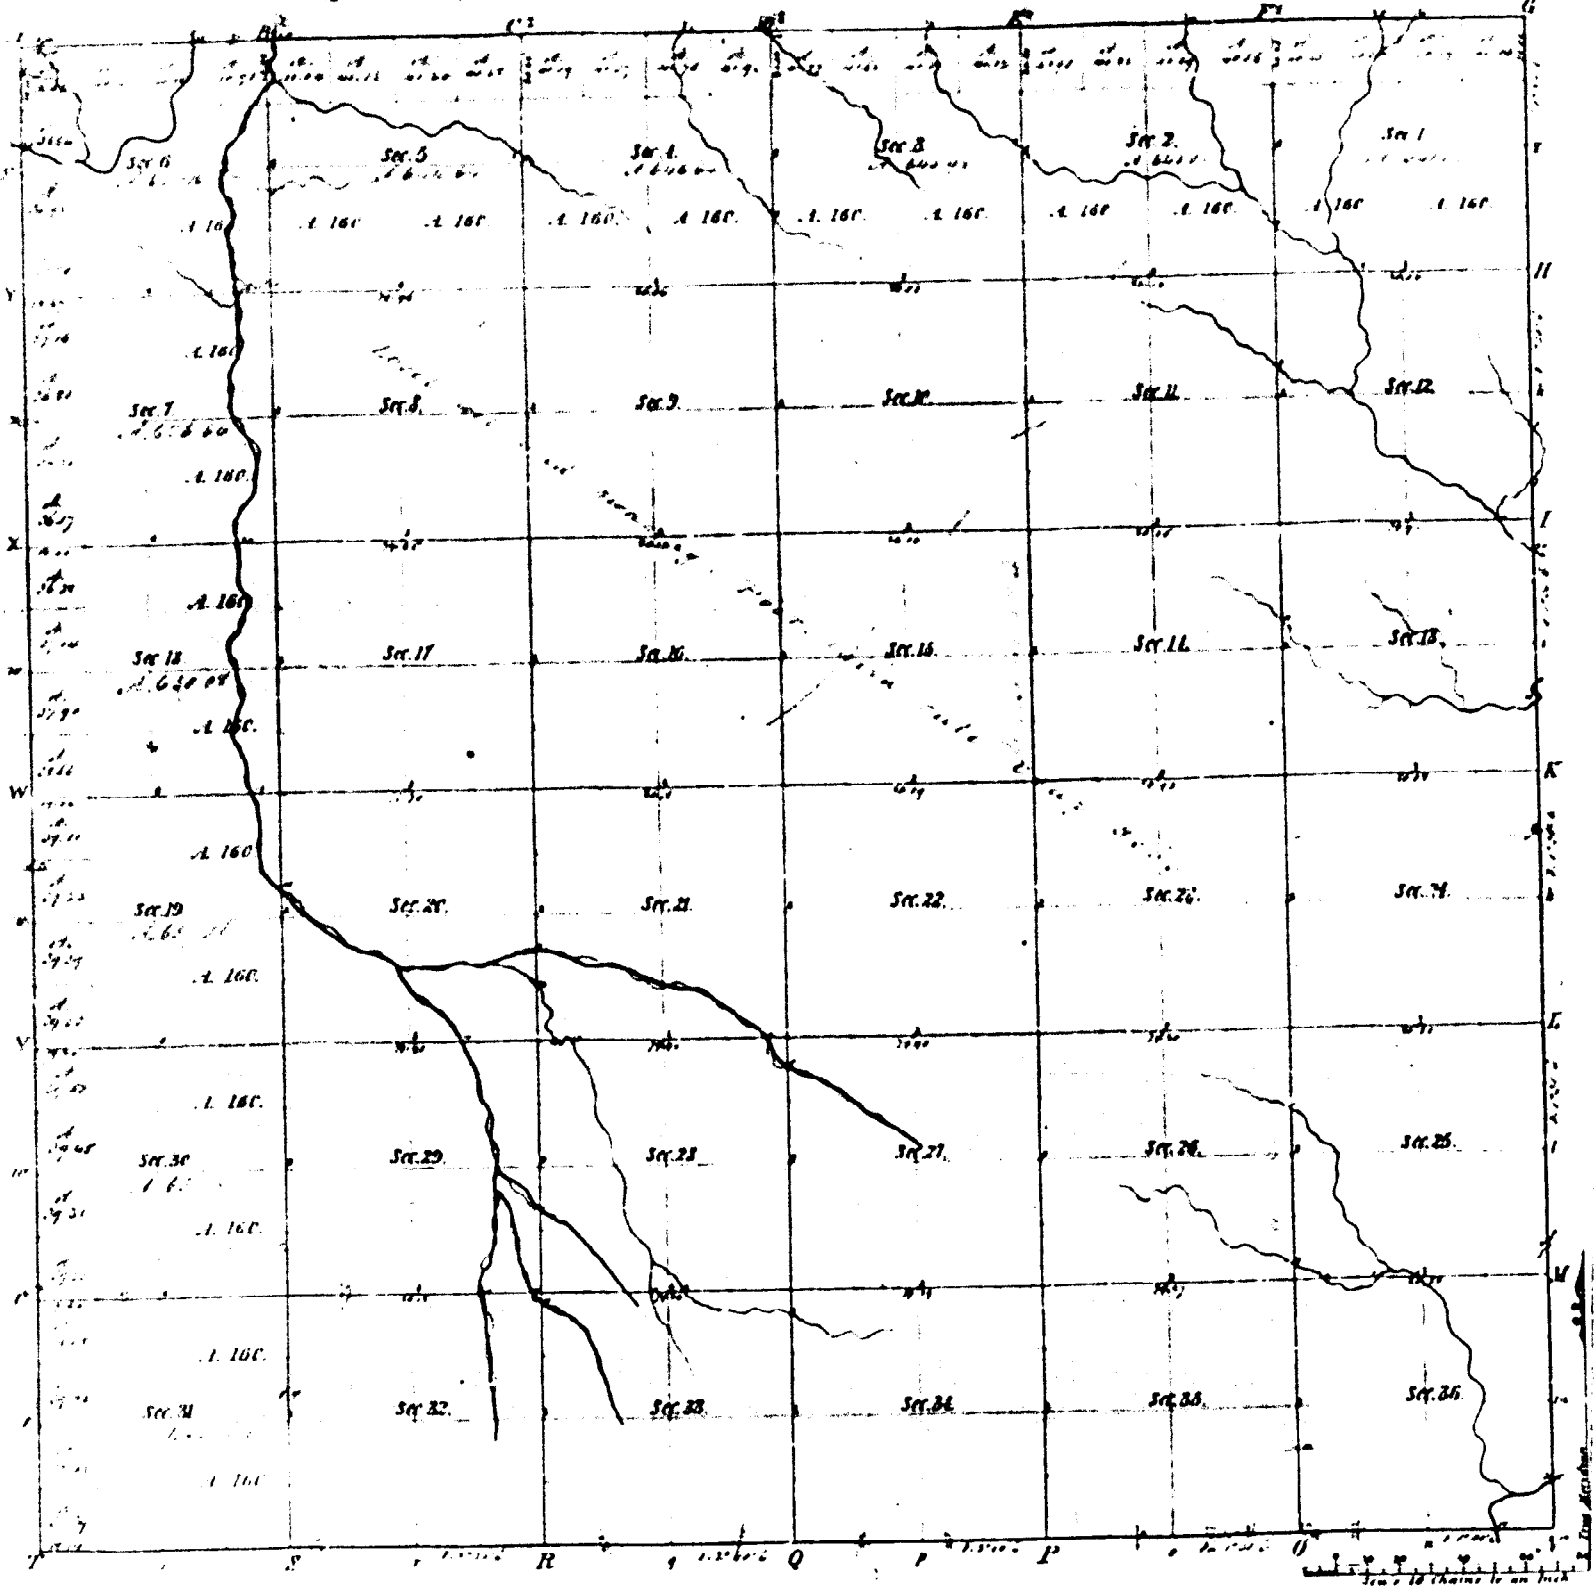

Total number of Acres 2,301 1/2

Who Surveyed	To Whom Devised	Date of Contract	Amount of Survey	When Surveyed	When Surveyed
John H. Muller	John H. Muller	Jan. 15 <sup>th</sup> 1845	M. 160 lks	5 <sup>th</sup> 9 <sup>th</sup> 1840	
John H. Muller	John H. Muller	April 2 <sup>nd</sup> 1845	54. 78. 49	3 <sup>rd</sup> 9 <sup>th</sup> 1845	

The above Map of Township N<sup>o</sup> 46 North of Range N<sup>o</sup> 1 West of the Principal Meridian in Michigan is a true and correct copy of the field notes of the survey thereof on file in this Office, which have been examined and approved.

Surveyor General's Office  
 Detroit, Decem<sup>r</sup>. 15. 1845  
 S. C. L. Lyon, Surveyor